


COUNTY SURVEYOR'S FILE DATA
DO NOT REMOVE FROM OFFICE

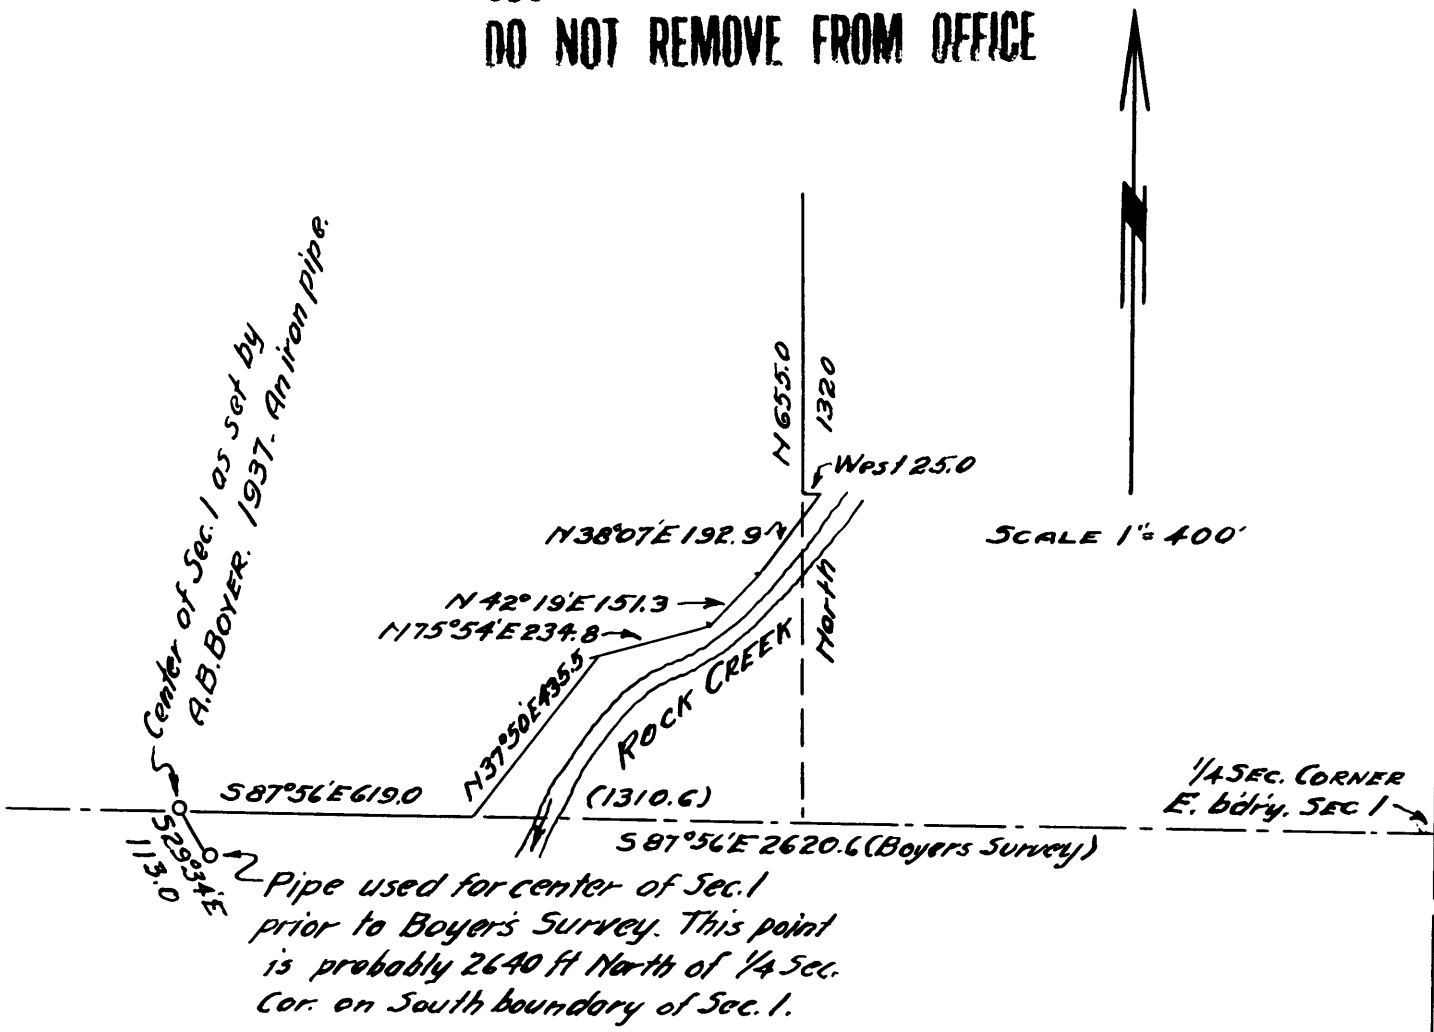

PART OF
SECTION 1 T. 26 S., R. 3 W., W.M.
SHOWING LINES SURVEYED FOR
W.C. FARNHAM
BEN. B. IRVING
CIVIL ENGINEER & SURVEYOR
ROSEBURG OREGON
MARCH 22 1940

CS FILE FOLDER

CONTAINS

MORE

INFORMATION