

JAN. 25-56
H. BYRON
WILKING
LITER VARRI

RENEW 1/4 COR 9 T 24S R 2W

COR. RENEWED FROM 8" FIR NOW
16" POTTER FIR STUMP FOUND
SCRIBED "8" A LOWER PART OF 2
SCRIBED ON NORTH SIDE. THIS IS
TO BE ORIG. MARKED FOR 1/4 COR.

SET BRASS CAP MKD 45 9
T 24S R 2W COUNTY 5 16
SURVEYORS OFFICE 1956

SET CAP AT NORTH SIDE OF STUMP
MOUND OF ROCK & STONE PLACED
BLAZED & SCRIBED 18 CEDAR
S 82° E 142.5' S 16' CS BT
BLAZED & SCRIBED 14"
N 82° W 152' 1/2 S 9' CS BT

C. S. File No. 47/91

RENEW SEC COR 9 10
16 15

T 24S R 2W

COR. RENEWED FROM ORG.

BT 15" NOW 30" FIR S 55° E 24.4'

BT IS DOWN FOUND BARK SCRIBED

3.15 GOOD CONDITION.

NO OTHER BTS FOUND

SET BRASS AT COR. MKD

9 10
16 15 SEC. COR. T 24S R 2W 17.56

COUNTY SURVEYORS OFFICE

BLAZED & SCRIBED 8" R. FIR,
S 32° E 37.3' S 15' CS BT

BLAZED & SCRIBED 56" CEDAR
S 82° W 24.4' T 24S R 2W 5 16
CS BT

BLAZED & SCRIBED 10" W. FIR
S 9' CS BT NORTH 33.8'

BLAZED & SCRIBED 16" W. FIR
S 10' CS BT T 24S R 2W N 40° E
35.0'

CS 47/91

Jan. 16, 1956

Fred Darby- County Engineer:



Have attached a description of two corners in Sec. 9, T. 24S, R. 7W, W. M. which are in need of re-establishment. Bearing trees are present as listed but will be non-recognizable soon. You can drive to within 200 feet of both corners with a jeep.

Jim Hart
B. L. M.

sec.
33,
22-4
Center
of Sec.

C. S. File No. 47/91

Section 9 Township 24S Range 7W

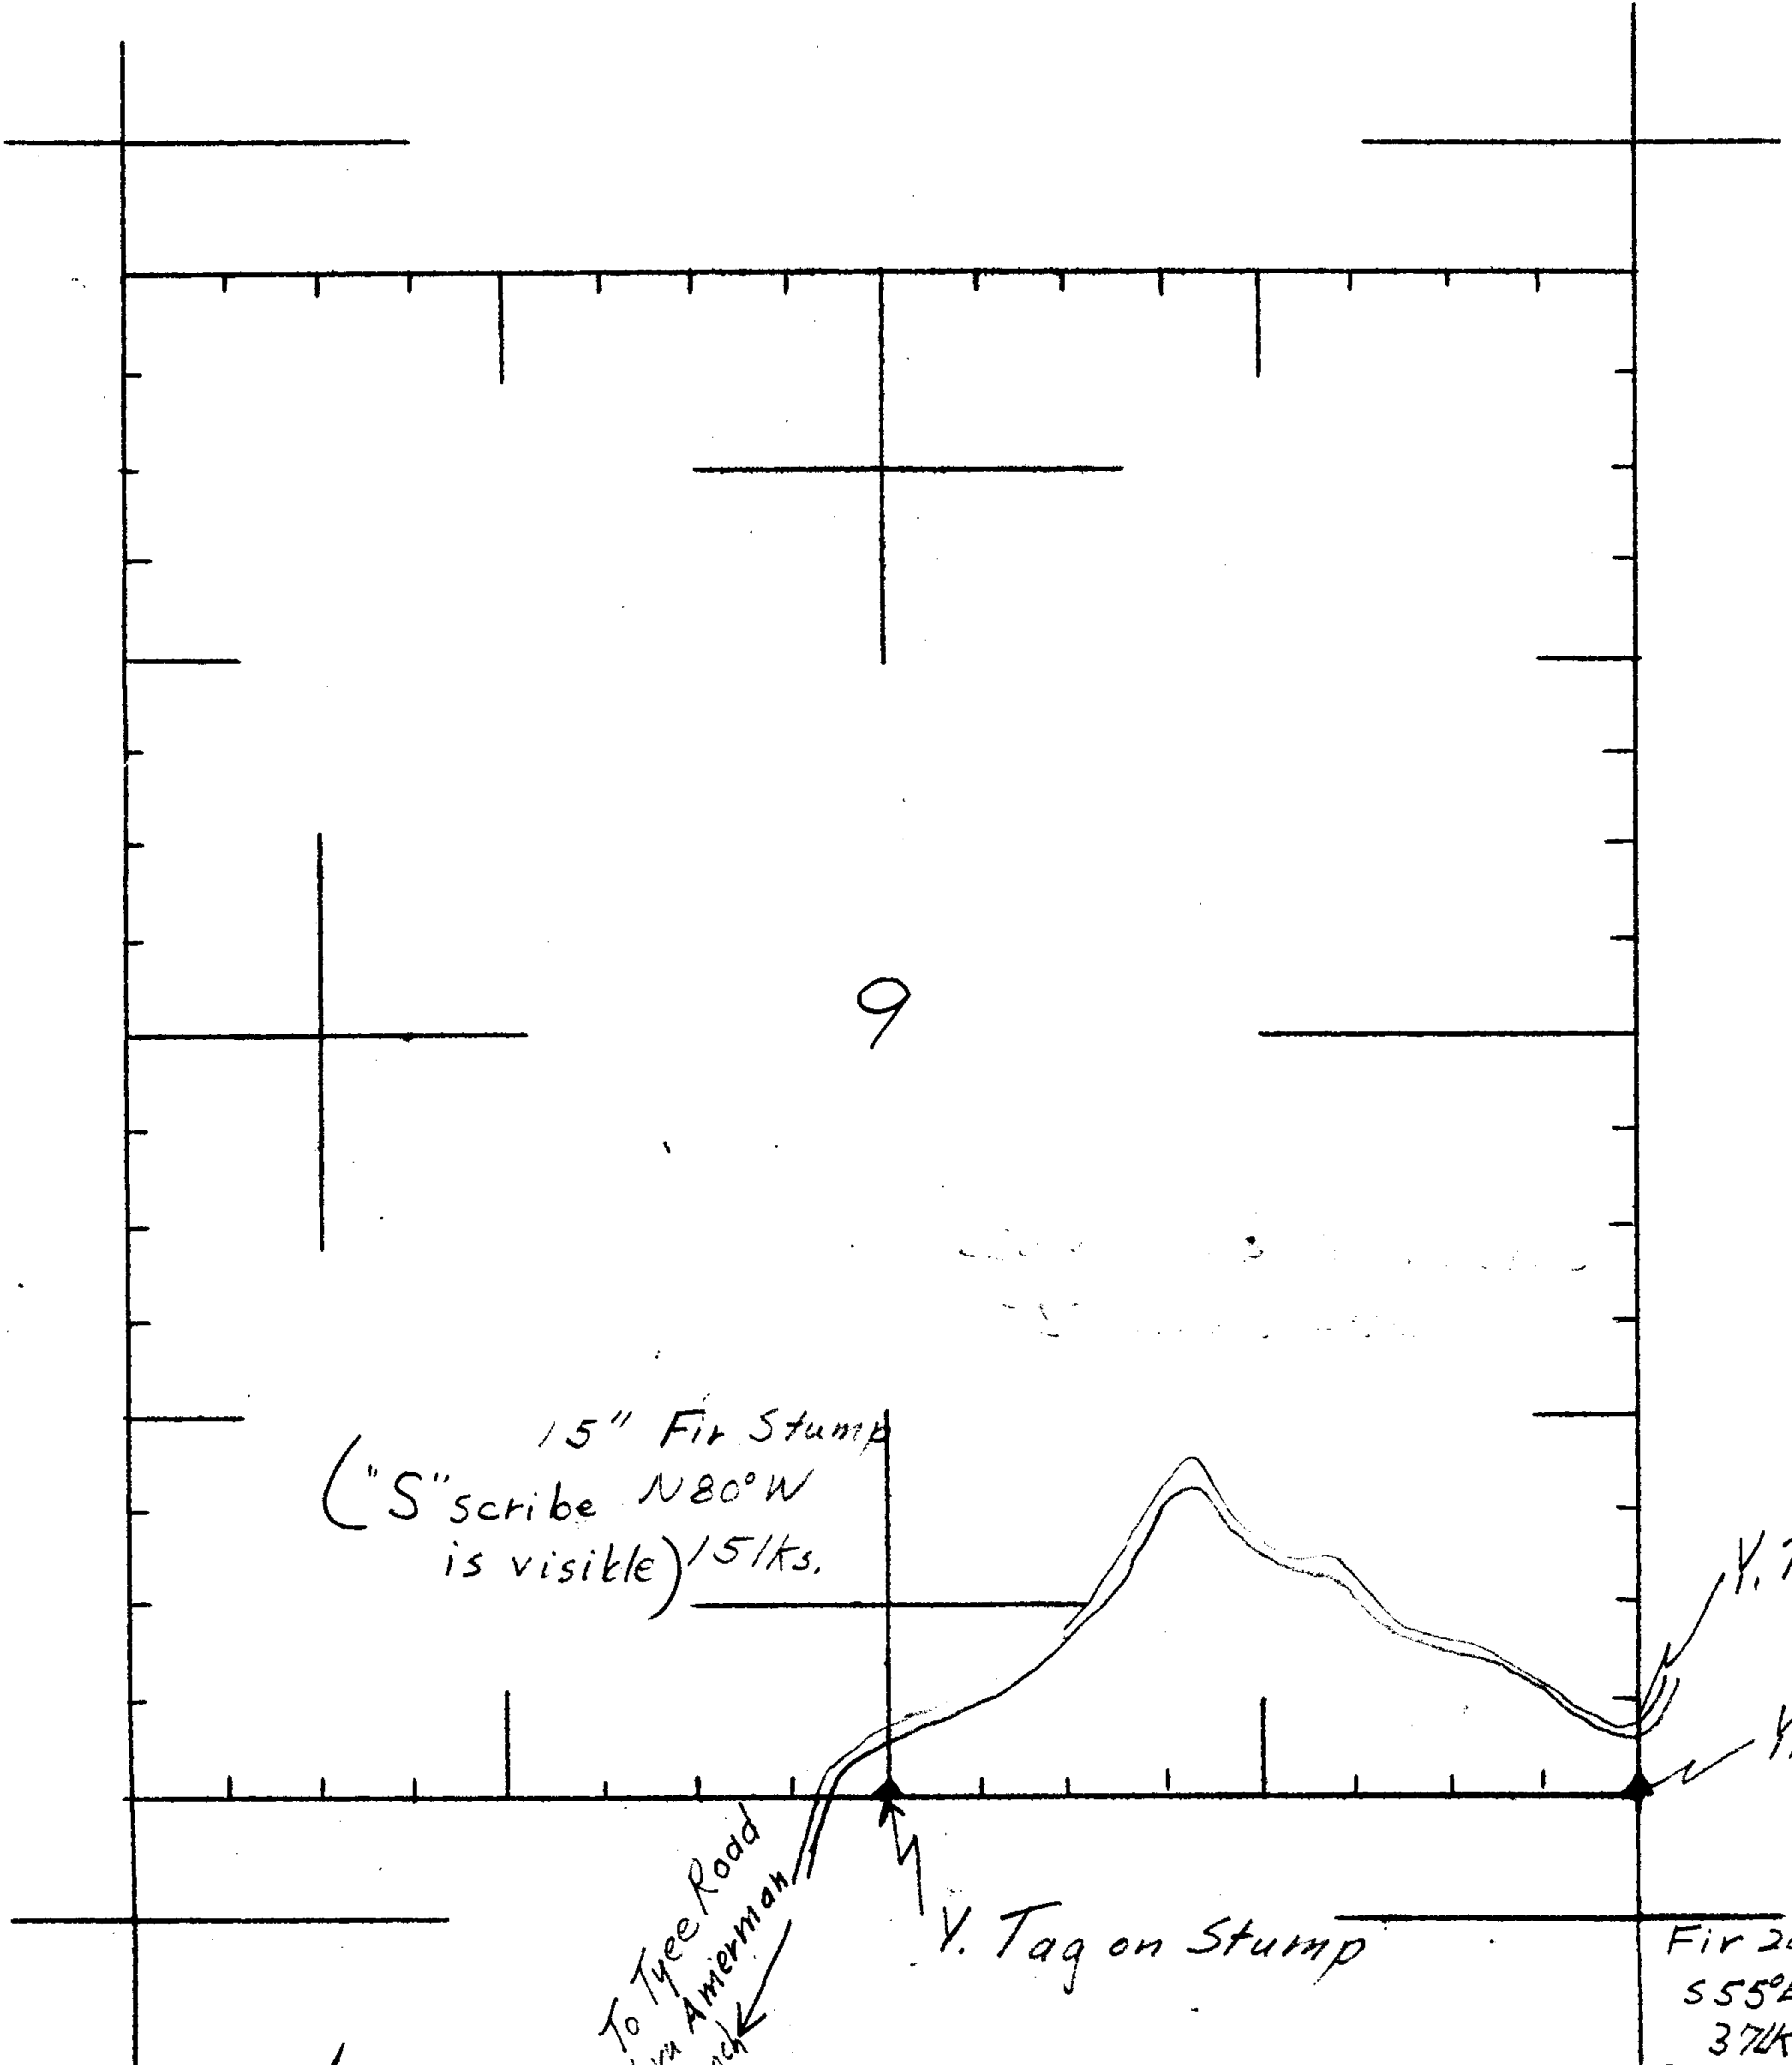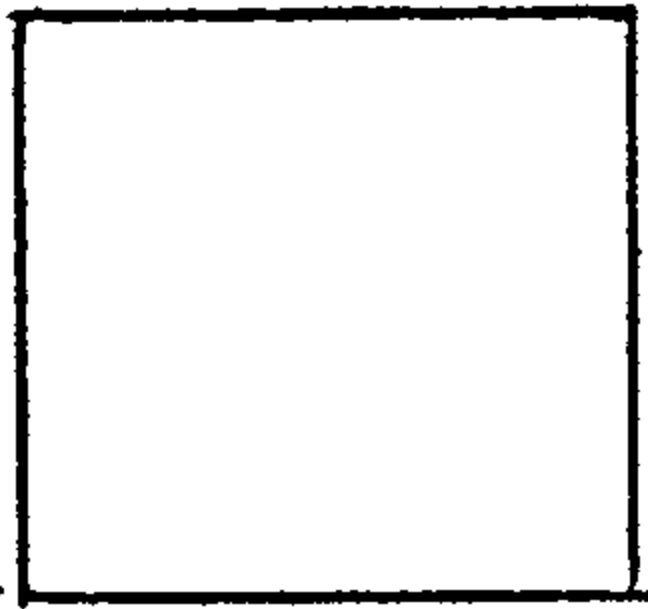

C. S. File No. 47/91