

COUNTY SURVEYOR
DOUGLAS COUNTY, OREGON



JUL 17 1956

FILED
RECEIVED

REGISTERED
OREGON
LAND SURVEYOR

Geo. J. Wenderoth

MARCH 10, 1944
George J. Wenderoth
5

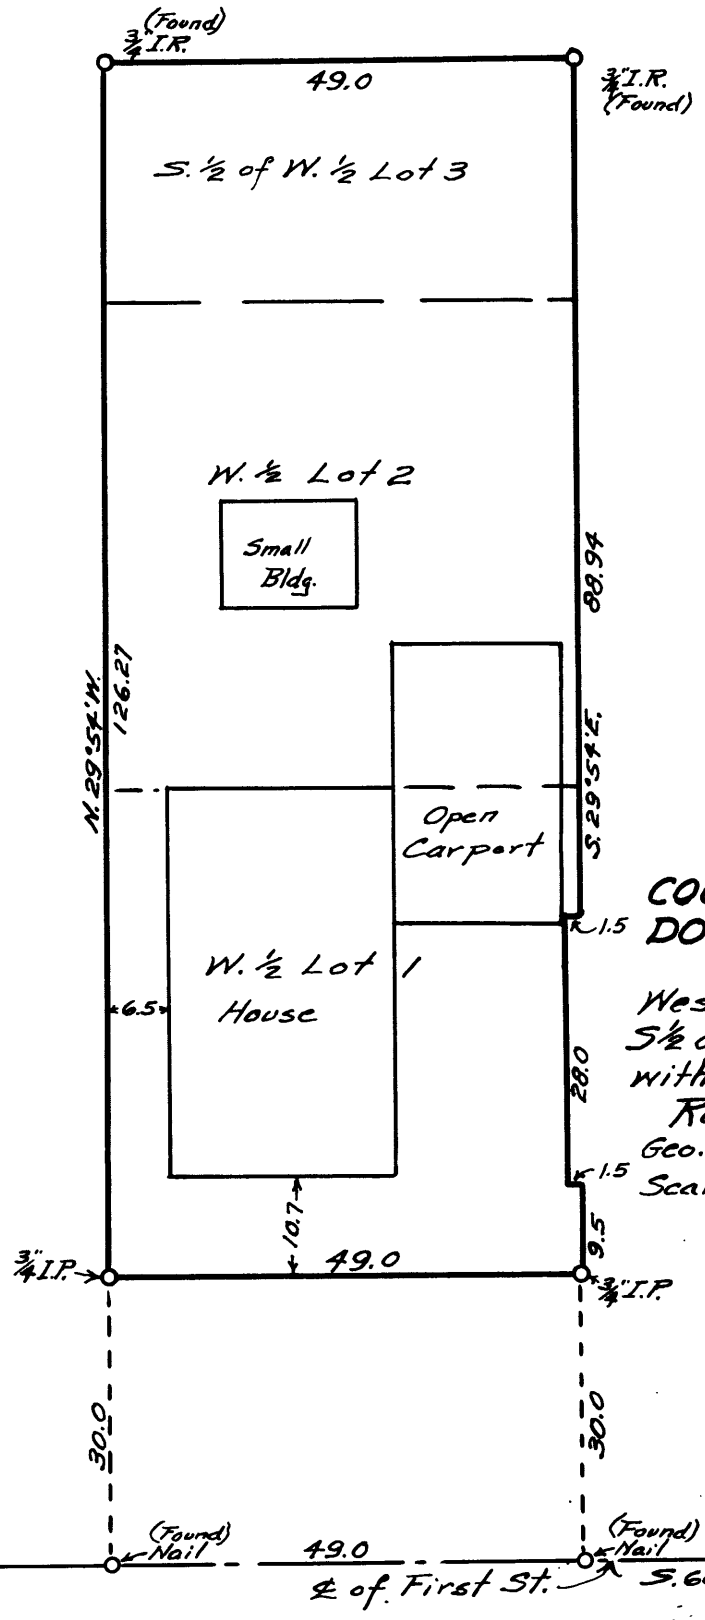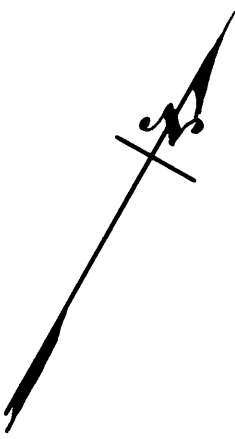

COUNTY SURVEYORS FILE DATA
DO NOT REMOVE FROM OFFICE

COUNTY SURVEYOR'S OFFICE
DOUGLAS COUNTY, OREGON.
SURVEY SHOWING
West 1/2 Lots 1 & 2 Blk. 13, Canyonville.
S 1/2 of W. 1/2 Lot 3 Blk 13, Canyonville
with Location of Buildings for
Robert Larson
Geo. J. Wenderoth, Deputy, June 1956.
Scale 1" = 20'

SE of Pine St.