

# FISK FRUIT FARMS

LOT 7

LOT 6

LOT 5


LOT 4

339.0  
340.26

332.2  
333.44

332.2 ← Plat 7 599.4'  
333.44 ← Adjusted 601.63 - Field

LANDERS LANE  
LOCATION PLAN  
SCALE 1" = 200'

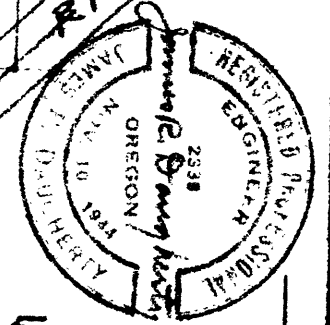


LOT 7

LOT 6

LOT 5

333.43

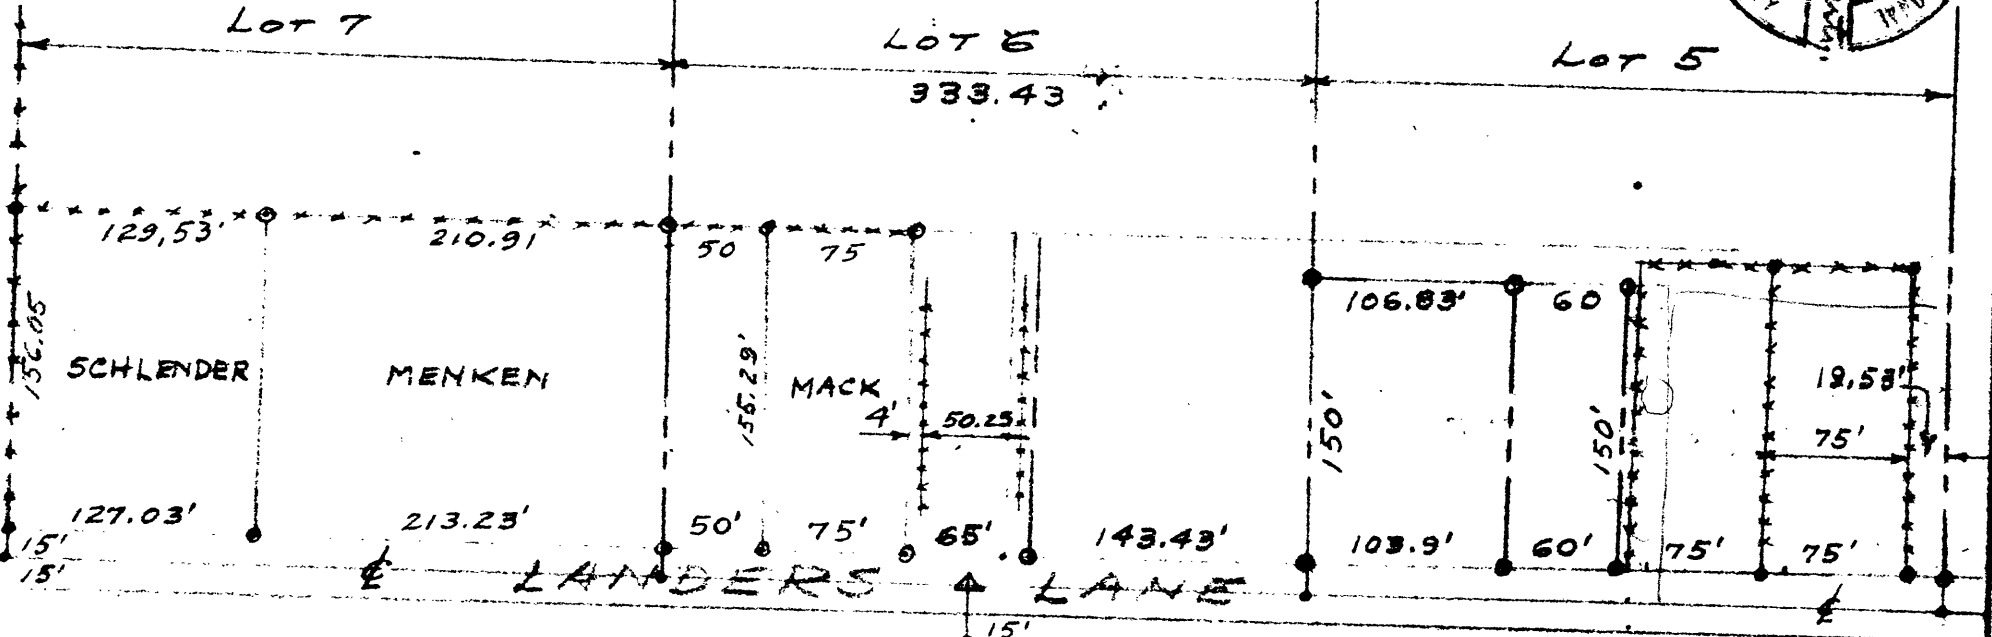

## PLAN OF SURVEY DATA - EXISTING FENCES

PRELIMINARY SURVEY BY  
JAMES R. DAUGHERTY  
CIVIL-SANITARY ENGINEER  
ROSEBURG - ORE

SCALE 1" = 100'

C. S. File No. 47/103 - 3

MAR. 12, '56.

.372/100' adj.