


RENEW S.W. COR. DLC 38 T 24 R4

(Sec. 21)

FOUND - ORIG. BTS OPEN & FIND  
SCRIBING. CHECKS FOR BEARING &  
DISTANCES.

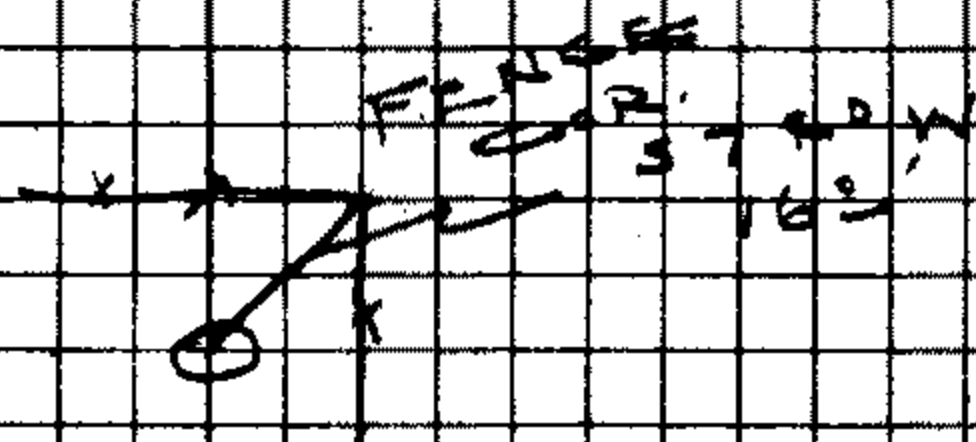

POSITION OF COR. DETERMINED  
FROM ORIG. BTS.

SET BRASS CAP MARK, SW DLC 38  
T 24 S R 4 W. COUNTY SURVEYORS  
OFFICE 1956.

FROM WHICH 9" W.O. BEARS N 60° E  
22.0'

9" W.O. N 80° E 33.9.  
SERIAL SW COR DLC 38 CS BT

SEPT. 28-56  
HONOR  
M.V.

DIETZEN NO. 385-6