

NE COR. D. L. C. N 297  
T 29 S. R. 6 W

No. 37


D. L. C.

0.34 AC

2.66 AC

SET 3/4" IRON ROD AT POINT  
OF DIVERSION  
PIPE LINE EASEMENT

STATE OWNED GRAVEL  
STATE OWNED BAR

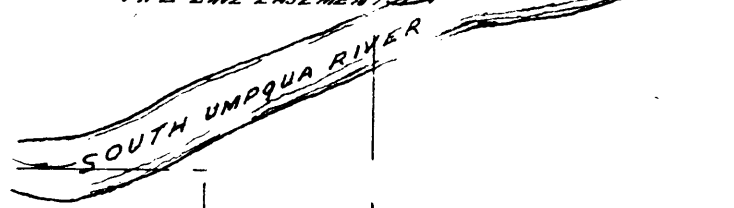

SCALE 8" = 1 MILE

No. 6

3

D. L. C.



James W. Byrnes

**WATER RIGHT  
FOR  
W. L. PAINTER  
SECTION 3, T. 29 S., R. 6 W. WM.  
OFFICE OF  
FRED M. DARBY  
COUNTY SURVEYOR, DOUGLAS COUNTY  
ROSEBURG, OREGON**

C. S. File No. 47/149

CS FILE FOLDER

CONTAINS

MORE

INFORMATION