

# LOT II RIVER BEND ACRES SECTION 23 T 26 S R 6 W W.M.


DOUGLAS COUNTY OREGON

NORTH UMPQUA RIVER ←

## FRED WARREN WATER RIGHT APPLICATION

Lot II Area = 0.7 Acre  
To be irrigated by 3/4" hose and sprinkler.

1" Pump & 3 HP Gas Motor

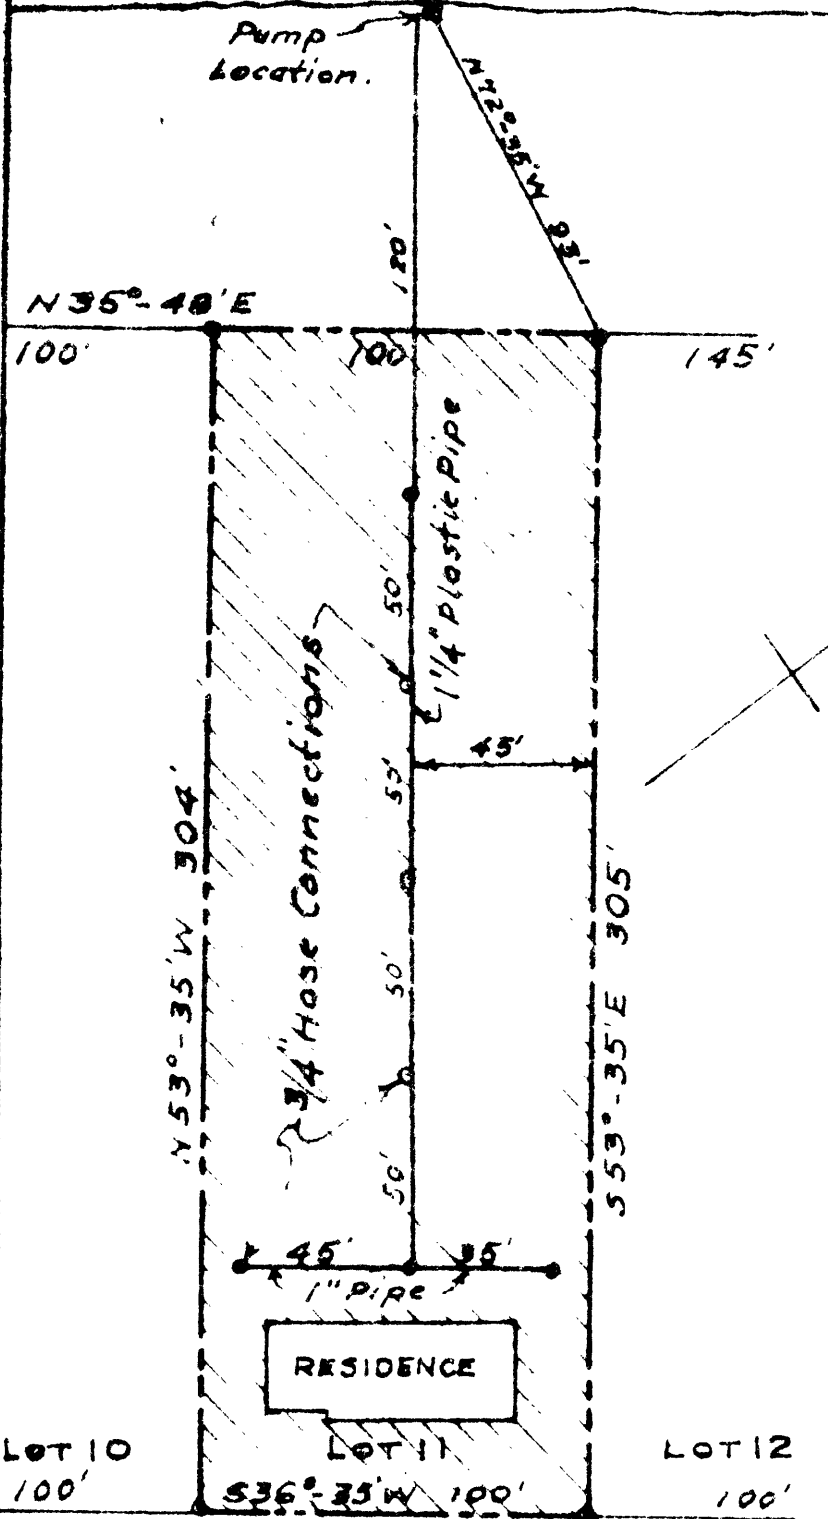

RIVER BEND ROAD 50'

SCALE 1" = 50'

SURVEYED & PLATTED BY  
**JAMES R. DAUGHERTY**  
CIVIL-SANITARY ENGINEER



Apr. 1956

ROSEBURG · ORE C. S. File No. 47/163

CS FILE FOLDER

CONTAINS

MORE

INFORMATION