

DIETZGEN NO. 385-6

TRIS RAW

C. S. File No. 47/180

RENEW $\frac{1}{4}$ COR. 32 T 285 R 4 W

FOUND - $\frac{1}{4}$ " I.P. AT COR. BENT

OVER BY CAT. REPLACED BY

BRASS CAP. THE 14" FIR S 2° 10' W

GOOD CONDITION & SHOWS GOOD FACE

I DO NOT OPEN TH 10" FIR S 70° 36' W

DOWN. BOTH B.T.S CHECK BEARING &

DISTANCE.

SET BRASS CAP AT COR. MKD.

$\frac{1}{4}$ S 32 T 285 4 W

5 T 295 4 W

COUNTY SURVEYORS OFFICE 1957

ALSO I FIND LOWER SECTION OF
CHARRED POST AS SET BY COLE
SAME LOC. AS $\frac{1}{4}$ " I.P.

BLAZED & SCRIBED 8" R FIR

N 8° W 23.2' T 285 R 4 W $\frac{1}{4}$ S 32

CS BT

APRIL 26 1957

J.T.B.

J.F.

M.G.

APW



RENEW 1/4 COR. 17 1/4 T 285 R 9W

FOUND ORIG SW BT (NOW 36" STOOD). FOUND & FOUND SCRIBING 1/4 S. THE N. & BT GONE.

SET BRASS CAP AT CORNER MKD 1/4 S 15 1/4 T 285 R 9W COUNTY SURVEYORS OFFICE 1957

FROM WHICH 8" CEDAR BEARS 3 10'E 31.5' I SCRIBED 1/4 S 14 CS BT 12" R. F. R BEARS N 68 1/2 W 333' I SCRIBED 1/4 S 15 CS BT

NOTE - CORNER IN ROADWAY SET BRASS CAP 2" BELOW SURFACE

DIETZGEN NO. 3885-B

C. S. File No. 47/180

RENEW $\frac{1011}{1514}$ T28S R4W

FOUND - ALL ORIG. BTS. AND ALL
HAVE OPEN FACES WITH SCRIBING
VISIBLE. EXCEPT THE NE BT, WHICH
SHOWS GOOD FACE. I DO NOT OPEN
ALL BTS CHECK FOR BEARING &
DISTANCES. EXCEPT N.E. IT CHECKS
FOR BEARING MEASURED DISTANCE
18.4' (RECORD 28.4')

SET BRASS CAP AT COR. MKD.

$\frac{1011}{1514}$ T28S R4W COUNTY SURVEYORS
OFFICE, 1957

APRIL 29-57
D.B.M.E. 514

BLAZE & BARK SCRIBE ORIG.

BT NOW 20" FIR N30°E 18.4'

S11 T28S R4W CS BT.

RESCRIBE ORIG BT NOW 26"

LAUREL N88°W 44.0' S10 T28S R4W

CS BT

RESCRIBE ORIG BT NOW 24"

CEDAR S5°W 28.4' S15 T28S R4W

CS BT

RESCRIBE ORIG. BT NOW 40"

CEDAR S40°E 51.3' S14 T28S R4W

CS BT.

66
5.5

67
414

68
250
250

DIETZGEN NO. 385-6

TRES RAW

C. S. File No. 47/180

APRIL 23-57

99619

99255

97661

95150

DIETZGEN NO. 385-6

99067

$$\begin{array}{r}
 87.7 \\
 297.2 \\
 \hline
 384.9
 \end{array}$$

$$\begin{array}{r}
 836.4 \\
 252.4 \\
 \hline
 1088.8
 \end{array}$$

98923

$$\begin{array}{r}
 12080 \\
 10892 \\
 \hline
 17972
 \end{array}$$

98604

C. S. File No. 47/180

8

15' 53"
7° 56' 1/2"

541° E

207°

~~550' 18' 30" E~~

~~81° 10'
40' 35"~~

427 + 365

392.9

59° 53' 30" E

DIETZGEN NO. 385-6

C. S. File No. 47/180

STEWARTS BT GOLF

FD 3/4"

1.P.

5/16 S 33 | 334

AT N. R/W FENCE
OF SLIDE CRK RD.

381.75

681.54

50° 22' W

52° W

-2° 10'
300°

11

18° 59'
9' 25 1/2 R

59° 07' 30" E

406.17

57° E

10

47° 58'
23° 59' R

333.05

53° 06' 30" E

9

18° 50 1/2'
9' 25 1/2 R

53° E L 333.05

207.0'

54° 32' E

541° E

427+365 L

15° 53'
7° 56 1/2 R

271.92

55° 28 1/2 E

8

81° 10'
40° 35' W

392.4

59° 58 1/2 E

RENEW C.V. 1/16 S34 T28 S R4W

FIND - 1/2" I.P. AT COR. & STUMP OF BT

I OPEN & FIND SCRIBE MARKS, CHECKS

BEARING & DIST.

BLAZE & SCRIBE NEW BT 16" CEDAR

N16 1/2 W 150.1' C.V. 1/16 S34 CS BT

FB 1/2" I.P.

C.V. 1/16 S34 T28 S R4W

135.6

S13°16 1/2 E S11 1/2 E

+1530'

1407

10-B

184°39'

92°19' R

L47

400.01'

N74°24'30" E

+1000'

1000'

+8°20'

3000'

10-A

POT

+6000'

2650'

+15°03'

1119'

991.97

N74°24'30" E

N74°52'30" E

+8°00'

3000'

L742

-0°40'

2490'

B.S
10

9899-9

155.8 1535

$$\begin{array}{r}
 296832 \\
 \underline{9848} \\
 29531
 \end{array}$$

96329

$$\begin{array}{r}
 481620 \\
 \underline{481620} \\
 96324 \\
 149.302 \\
 150.1
 \end{array}$$

96363

98481

~~98949~~

DIETZGEN NO. 385-6

C. S. File No. 47/180

APRIL 25-57

J. B.
M. G.
J. H.

DIETZGEN NO. 385-6

FD 3/4 11P.
12" ABOVE GR.

C. S. File No. 47/180

RENEW $\frac{1}{4}$ S 13 T285 R4W
24

FOUND - ORIG. SOUTH BT
NOW 40" R. FIR BARK SCRIBED
 $\frac{1}{4}$ S BT BT IN GOOD CONDITION
ALSO FIND WHAT I BELIEVE TO BE
ORIG. MAPLE BT NO SCRIBING
FOUND CENTER ROTTED CHECKS
LINE & DIST. TO OLD $1\frac{1}{4}$ " X $2\frac{1}{2}$ "
BAR.

SET BRASS CAP AT COR. &
ALONGSIDE OLD IRON BAR. MKD
 $\frac{1}{4}$ S 13 T285 R4W COUNTY
SURVEYORS OFFICE 1957.

FROM WHICH 2.1" W. FIR
BEARS N61°E 16.8' SCRIBE $\frac{1}{4}$ S 13
C.S. BT.

THE ORIG. SOUTH BT BEARS
S 3°E 46.9' DO NOT RESCRIBE

APRIL 30-57

J. B.

M. G.

J. F.

VAR. $20\frac{1}{2}$ °

RENEW 1/4 COR. 23 T 85 R 4 W

FD 2" SQ STAKE AT COR
FD BRASS STAKE BT 18' NOW 30'
RED FIR S 10° E 30.4' BARK SCRIBED
1/4 S 23 BT

ALSO FIND LOW CUT STUMP CHECKS
FOR BEARING & DIST. & SIZE NO SCRIBING
FD.

ALSO FD. ORIG BT UPRATED AND
DOWN SLOPE ABOUT 20' BARK SCRIBED
BT. FOUND HOLE FOR BT WHICH CHECKS
BEARING & DIST S 15° E 21.8'

SET BRASS CAP AT COR MKD 1/4 S
23 T 85 R 4 W COUNTY SURVEYORS
OFFICE 1957

FROM WHICH I BLAZE & SCRIBE
12' HEMLOCK N 60° E 17.8' 1/4 S 23 CS BT

MAY 13TH 1957

J. B.

M. G.

J. F.

VAR. 20 1/2"

DIETZGEN NO. 385-6

G. S. File No. 47/180

RENEW $\frac{211}{1112}$ TRS R+W

FOUND ORIG. N W BT FACE

OPEN GOOD SCRIBING VISIBLE

NOW 36' CEDAR, ALL OTHER

BTS. GONE.

SET BRASS CAP AT RECORD

DISTANCE & BEARING MKL S $\frac{211}{1112}$

TRS R+W COUNTY SURVEYORS

OFFICE 1957.

FROM WHICH -

BLAZED & SCRIBED 14" R, FIR.

WEST 5.2' S 11 TRS R+W CS BT.

12" R, FIR N47°E 9.7'

S 1 TRS R+W CS BT

20" R, FIR S 71°E 30° 512

TRS R+W CS BT

MAY 7-57

J. B.

M. G.

J. F. VAR 20 1/2

DIETZGEN NO. 385-8

T 283 R 4W

C. S. File No. 47/80

	618.59		57°17'30"W	
				59°00
14		112°30' 56'15"R		
	534.99			S 48 1/2 E L 236.5'
				-5'45"
4074.2385 13		51°5' 75'55" L	549°57'30"E	300'
	469.8		526°57'30"W	
				528 1/2 W
12		31°09' 15'34 1/2 R		
	610.3		511°23'W	
				513°W
11		41°01' 20'30 1/2 R		
			5907'30"E	
B.S. 10				
FD. NW COR. LOTS				
- 1/2" I.P. BT STUMP ONLY NOW 28' CHECKS BEARING & DIST.				
	207.19			549°W
				+16'20'
			547°47 1/2 W	215'
11		113°49 1/2 56°55" P.		
			571°37'30"E	
10				

528°35'10

92
77.00

9
15

406 + 40,3
FD BOLT

FD BOLT



DIETZGEN NO. 385-6

45964

C. S. File No. 47/180

33/34

~~4/3~~

FD 1/2" I.P.

ATCOR.

BTS OK CHECK FOR BEARING &

DIST I OPEN SE. BT &

FIND GOOD SCRIBE MARKS.

78' 4"

S.W. BT SHOWS GOOD FACE

1200

NO OTHER TREES SUITABLE.

L5002

RENEW SEC. COR 25/28
3233 TRPS RAW

FOUND 36" CEDAR N 5° E 9.8' GOOD
SCRIBING VISIBLE ALSO FR. STUMP OF
MARKHAM'S N W BT SCRIBED BT CHECKS
BEARING 32° DIST. ALL OTHER BTS
DOWN OR GONE

NOTE - COR 1' SW FROM COR. FENCE
POST.

SET BRASS CAP. MKD. CAD SEC COR
TRPS RAW COUNTY SURVEYORS
OFFICE 1957

SCRIBED NEW TREES

24" CEDAR S 55° W 57.9' SCRIBED
S 32 TRPS RAW CS BT
5" R FIR N 68° W 35.7' SCRIBED
S 29 CS BT
20" CEDAR S 82° E 34.5' SCRIBED
S 33 TRPS RAW CS BT

MAY 9-57

J. B.

M. S.

L. F.

VAR 20.1°

DIETZGEN NO. 385-6

C. S. File No. 47/180

RENEW $\frac{1}{4}$ COR. $\frac{29}{32}$ T28S R4W

FOUND - OLD 2' STAKE AT COR.
BARK
\$ 34" R FIR STUMP, SCRIBED CS BT
S 9' E 41° (RECORD 497). FOUND
1P" LAUREL OPEN FACE \$ GOOD
SCRIBING. FOUND 48" FIR STUMP
WITH CHIP AT BASE BARK SCRIBED
 $\frac{1}{4}$ S N 23 $\frac{1}{2}$ ° W 30.2'

SET BRASS CAP ALONGSIDE OLD
FIR STAKE. MARK CAP $\frac{1}{4}$ S $\frac{29}{32}$
T28S R4W COUNTY SURVEYORS
OFFICE 1957

ERISE NEW BT
20" CEDAR S 19 $\frac{1}{2}$ ° W 42 $\frac{1}{4}$ S
32 CS BT.

DIETZGEN NO. 385-6

C. S. File No. 47/180

RENEW ✓ 1/4 COR 33/34 T285 R4W

RETRACED STEWARTS 1922

SURVEY TO FIX POSITION OF THIS COR.

SET BRASS CAP AT COR. MKD. 1/4

S 33/34 T285 R4W COUNTY

SURVEYORS OFFICE 1957.

BLAZED & SCRIBED 14" MAPLE S32°E

100' 1/4 34 CS BT

BLAZED & SCRIBED 10' EWINGWOOD COR. POST

S40°W 1/4 33 CS BT

1/4 COR.
33/34

16339

S77°13 1/2 E

9-A

8°35' R


S85°48 1/2 E

9

RENEW N 1/4 S 33 | S 34 T 285 RAW

FD 1/2 I.P. & BASE OF ROTTED STUMP
WHICH CHECKS BEARING & DIST FOR
STEWARTS BT

BLAZE & SCRIBE 10" CEDAR N 25° E
39' N 1/4 W S 34 CS BT

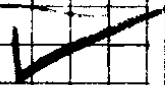

RENEW SEC. COR. 3132 T 285
S 5 T 285 RAYN

FOUND - THREE FIR STUMPS SHOW GOOD
FACES CHECK BEARINGS & DISTANCES AS
RECORDED BY COIN 1915. THE S 29 1/2° E
42" PINE BT IS GONE. I OPEN 22" NOW
28" FIR S 21° E 1056' & FIND GOOD SCRIBE
MARKS

SET BRASS CAP AND S 10 T 285
COUNTY SURVEYORS OFFICE 1915

DIETZGEN NO. 385-6

NEW BTs

8" CEDAR S 33° E 94' SCRIBED
T 295 RAW S 5 CS BT

8" R. FIR S 24° W 290' SCRIBED
T 295 RAW S 6 CS BT

10" B.O. N 77 1/2° W 220' SCRIBED T 285
RAW S 31 CS BT

14" PINE N 60 1/2° E 490' SCRIBED T 285
RAW S 32 CS BT

C. S. File No. 47/180

RENEW TOWN COR.

36/31

T 285

1/6

T 295

RSW

RAW

FOUND - 3 ORIG. B.T.S. TO OPEN NE
BT FOUND GOOD SCRIBING. THE NW
BT GONE STUMP HOLE ONLY. DO NOT
OPEN SW OR SE B.T.S. SHOW OLD BLAZES
ALL CHECK FOR BEARINGS & DIST

NOTE COR. 10' WEST OF N.S. FENCE

SET BRASS CAP MKD -

35/31 T 285

COUNTY SURVEYORS
OFFICE 1957

250

1/6 RAW

T 295

DIETZGEN NO. 385-6

BLAZE & SCRIBE 20" R.F.R. NW
28' 0" W 108' T 285 R SW S 36 C 3 BT

BLAZE & SCRIBE 12" R.F.R. S 46' W
542 T 285 R SW S 1 C 3 BT

BLAZE & SCRIBE 12" R.F.R. S 49' E
509' T 285 R SW S 6 C 3 BT

REBLAZE & RESCRIBE ORIG. N 31' 0" E
16" B.O. (NOW 24") T 285 R SW S 31 C 3 BT
251

MAY 16-57

H.B.

M.G.

L.H.

RENEW SEC. COR. 35/36 T28S

2/1 T29S

J.R. VAR 20%
MS. MAY 16-57
J.F.

R5W

FOUND - ALL OF COLES BTS.

THE NE BT STUMP ONLY & ROTTED
FACE WELL SCRIBED ALL OTHER BTS
DOWN & ROTTED BUT SOME SCRIBING
VISIBLE. ALL BTS CHECK FOR BEARING
& DIST.

SET BRASS CAP AT COR. MKD

35/36 T28S
2/1 T29S

R5W COUNTY SURVEYORS
OFFICE 1957

BLAZE & SCRIBE 4" LAUREL 57.4'

58 1/2° W 52 CS BT

BLAZE & BARK SCRIBE 54" R. FIR

72.2° S 1 T29S R5W CS BT 524° E


BLAZE & SCRIBE 4" R. FIR N18 1/2° W

22.2° S 35 CS BT

BLAZE & SCRIBE 4" LAUREL N46° E

25' S 36 CS BT

I BELIEVE THIS TO BE
STONE SET BY COLE FOR
SECTION COR. (UNDER R5W)
FENCE

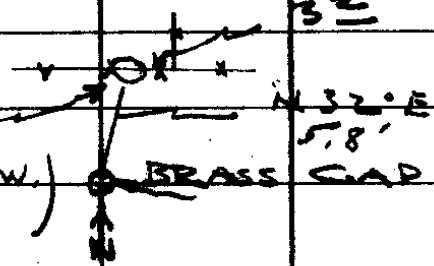

RENEW 1/4 COR. 6/5 T295 R4W

FD - STUMPS OF BOTH BITS AS SET
BY CAIN CHECK FOR BEARINGS &
DISTANCES ALSO BOTTOM SECTION
OF COR. POST FOUND (IN PLACE)
HOLE IN NW BIT & FIND "BT" MARKED
AND IN GOOD CONDITION I DO NOT
DEEM SET - SHOWS GOOD FACE

SET BRASS CAP AT COR. AND
1/4 S 6/5 T295 R4W COUNTY
SURVEYORS OFFICE 1957

BLAZE & SCRIBE 20' LAUREL
S28E 412' 1/4 S S COR

BLAZE & SCRIBE 5" RIFLE 93.3'
N14W 1/4 S G COR

DIETZGEN NO. 385-6

VAR. 20 1/2

MAY 15-57
L.S.
T.L.

C. S. File No. 47/180

S 85° E 50.5' ✓

RENEW $\frac{1}{4}$ COR. $\frac{31 T 28 S}{6 T 29 S}$ R 4 W

FOUND - NE BT ALIVE BUT CENTER ROTTED. I OPEN UPPER PART OF ORIG FACE & FIND REVERSED SECTION OF SCRIBE MARK. ALSO FIND 29" R.O. DOWN OLD FACE BURNED OUT NO SCRIBE MKS. FD. CHECKS FOR BEARING & DIST. TO STUMP HOLE AND KIND BTS. CHECK FOR SIZE OF ORIG. BTS. ALSO FIND $\frac{1}{2}$ " I.P. AT COR. UNDER N.S. FENCE. SET BRASS CAP AT COR. MKD.

$\frac{1}{4}$ S 31 T 28 S R 4 W COUNTY SURVEYORS
6 T 29 S
OFFICE 1957

BLAZED & SCRIBED 14" CEDAR
S 85° E 50.5' $\frac{1}{4}$ S 6 T 29 S R 4 W
CS BT

BLAZED & SCRIBED 18" CEDAR
28.2' N 7 $\frac{1}{2}$ ' W $\frac{1}{4}$ S 31 T 28 S R 4 W
CS BT

S.W.B.

MAY 15-57

M.G.

J.F.

VAR 20 $\frac{1}{2}$ '

BYARS 1881 ✓ T 28 S R 4 W

COR. SECS 17 | 16

20 | 21

ORIG. NOTES

16" FIR N 60° E 30 lks. 198

20" FIR S 45° E 26 lks. 172

30" FIR S 30° W 49 lks. 323

20" FIR N 28° W 60 lks. 396

C. S. File No. 57/100

COR. SET FROM ONE OLD BT.

44" FIR N 28° W 39 1/2 FT.

BARK SCRIBING PLAINLY VISIBLE
"S 17 T 28 S R 4 W BT"

MARK 16" CEDAR N 51 1/2° E 8.5 FT
(T 28 S R 4 W S 16 CS BT)

MARK 14" MADRONE S 56° E 21.6 FT,
(T 28 S R 4 W S 21 CS BT)

MARK 20" FIR S 37° W 19 FT.

BARK SCRIBE (T 28 S R 4 W S 20 CS BT)

FROM COR. AS SET A 40" FIR TREE BEARS

N 21° W 16.4 FT (TO CENTER OF TREE)

ON THE EAST SIDE OF THIS TREE ARE 4 NOTCHES
& THERE ARE 3 NOTCHES ON SOUTH SIDE

"S 16" IS BARK SCRIBED ON N.E.

"S 21" IS BARK SCRIBED ON S.E.

DEFINITE SCRIBE MARKS ARE ALSO VISIBLE ON N.W. & S.W.

SIDES BUT I CAN NOT READ THEM.

THEY ARE FRAGMENTARY BUT UNMISTAKABLE.

ALL NOTCHES AND SCRIBING IS VERY OLD

I BELIEVE THIS TO BE AN ORIGINAL CORNER

A DILIGENT SEARCH WAS MADE FOR
THE OTHER THREE ORIGINAL B.P.S
BUT NO TRACE OF THEM COULD BE
FOUND.

JUNE 10-57

J. B.

M. G.

J. H.

VAR. 20 1/2'

NOTE - THIS CAP. RENEWED AS
PER INSTRUCTIONS BY CADASTRAL
ENGINEER, LETTER DATED MAY 21-57

SET UP OF BRASS CAP
MND. "COUNTY SURVEYOR'S OFFICE
1957 - T 28 S R 4 W

S 17 / S 16 "

S 20 / S 21

REVIEW $\frac{28}{33} \frac{27}{34}$ T28S R4W

FD - 3/4" I.P. AT COR. THE

THE 10" W.O. AS SCRIBED BY BYARS
DOWN TO OPEN AND FIND SCRIBE MARKS
ON CHIP OF OLD FACE. CHECKS BEARING
S 15° E MEASURES 63.1' RECORD 6FG'
ALSO LOW CUT STUMPS FOR S.W. &
N.W. BTS NO SCRIBING LEFT.
BOTH BTS CHECK FOR SIZE, BEARING
& DISTANCES.

BLAZE & SCRIBE 6" W.O. EAST
4.7' S 27 T28S R4W CS BT

BLAZE & SCRIBE 10" MAPLE
S 79° W / 29.6' S 33 T28S R4W CS BT.

BLAZE & SCRIBE 10" W.O. S 37° E
(ON SLOPE 64.5') S 34 T28S R4W CS BT

BLAZE & SCRIBE 12" FIR N 36° W
(ON SLOPE 100.0') S 28 T28S R4W CS BT

J.B.

M.G.

J.F.

VAR 20' N

APR 20 - 57

CS FILE NO. 47/10

RENEW $\frac{1}{4}$ COR ✓ 28/27
T 28'S RAW

FOUND - 12" FIR (NOW 30" FIR)
N 78° E 11.9' I OPEN & FIND GOOD
SCALING. TAKE N.W. BT DOWN
HUGE N.E. BT TO FIX POSITION
OF COR.

SET BRASS CAP AT COR MKD
 $\frac{1}{4}$ S 28/27 T 28'S RAW
COUNTY SURVEYORS OFFICE 1957

FROM WHICH 16" FIR BEARS
S 24° W 27.9' MKD $\frac{1}{4}$ S 28 CS BT

FROM WHICH 6" CEDAR BEARS
S 76° E 41' MKD $\frac{1}{4}$ S 27 CS BT

J.B.
M.G.
J.F.

APRIL 20-57
VAR 20 1/2°