

T 28 S R 8 W

FOUND <sup>2"</sup> IRON PIPE WITH BRASS CAP  
MARKED " U.S. GENERAL LAND OFFICE  
SURVEY

T 28 S	)
R 8 W	R 7 1/2 W
S 1	S 6
S 12	S 7

ALSO FOUND 32" FIR N 72° W 34.8 FT.  
SHOWING GOOD SCAR - DID NOT CHOP OUT

18" W. FIR N 37° E 23.8 FT.

SHOWING GOOD SCAR - DID NOT CHOP  
OUT.


14" FIR S 19° W UPROOTED & DOWN  
CHINQUAPIN BRUSH GROWING AT  
LOCATION FOR S.E. 8.T.

NEW TREES BARK SCRIBE 22" DOUGLAS FIR  
S 70 1/2° W 22 1/2 FT.  
T 28 S R 8 W S 12 C S BT


BLAZE & SCRIBE

8" INCENSE CEDAR  
S 49° E 28 1/2 FT.

T 28 S R 7 1/2 W S 7 C S BT

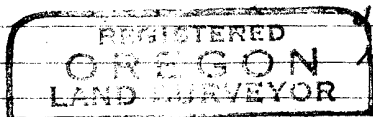

JULY 29, 1957  
M.E. GODFREY  
JOHN FEE

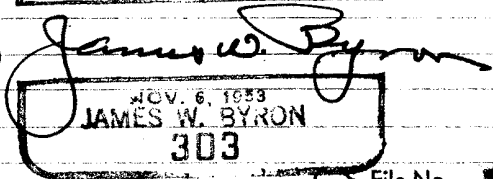

NOV. 6, 1953  
JAMES W. BYRON  
303

U.S. File No. 495-8