

R5W R4W

SET WIT. COR. FOR  $\frac{1}{4}$  COR. 12 | 7 T 28 S

NO ORIG. BTS FOUND.

POSITION OF  $\frac{1}{4}$  COR. FIXED BY SURVEY  
SECTION 12 SEE AS FILE #

$\frac{1}{4}$  COR. FOUND IN SMALL STREAM SET BRASS  
CAP 100' NORTH. MARKED THUS

COUNTY SURVEYORS OFFICE 1957 T 28 S

WIT COR. 10'S TO  $\frac{1}{4}$  COR. 512 57


R5W R4W

NEW BTS.

15" MAPLE BEARS NG 2  $\frac{1}{4}$  W 30.5'  
SCRIBED W.  $\frac{1}{4}$  S 12 CS BT

5' W OAK BEARS S 30.0' E 48.0'  
SCRIBED W. CS BT

DIETZGEN NO. 385-B

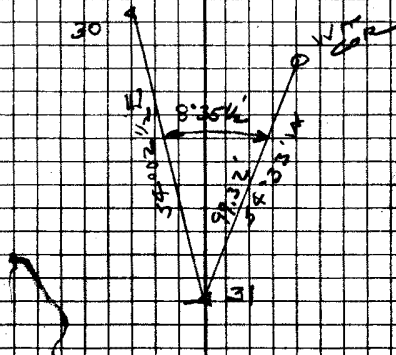

C. S. File No. 49/21-51