

RENEW $\frac{1}{4}$ COR. $\frac{12}{3}$ T283 R5W


No ORIG. B.T.S. FD.
POSITION OF $\frac{1}{4}$ COR. DETERMINED BY
SURVEY DEC 12 T283 R5W 4th CS
FILE #

SET BRASS CAP AT CORNER MKD.
 $\frac{1}{4}$ $\frac{312}{313}$ T283 R5W
COUNTY SURVEYORS OFFICE 1957

NEW B.T.S.

18" B.O. BEARS N 81° W 171.5
SCRIBED $\frac{1}{4}$ S 12 CS BT

11" R.F.P. BEARS S 5° E 437'
SCRIBED $\frac{1}{4}$ S 13 CS BT

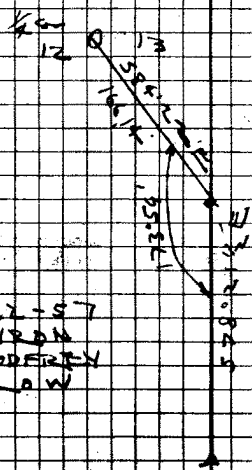

NAV. 27-57
J. D. BYRON
M. GORDEN
S. BILLOW

DIETZGEN NO. 385-6