

RENEW $\frac{1}{4}$ COR. 2 | 1 T285 R5W

NO ORIG. BTS FOUND



SEE CS FILE # FOR METHOD USED TO DETERMIN POSITION OF THIS COR.

SET BRASS CAP AT CORNER MKD.

$\frac{1}{4}$ S 2 | 3 T285 R5W

COUNTY SURVEYORS OFFICE 1957

NO SUITABLE TREES NEAR FOR BTS.

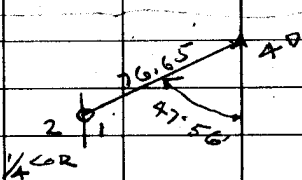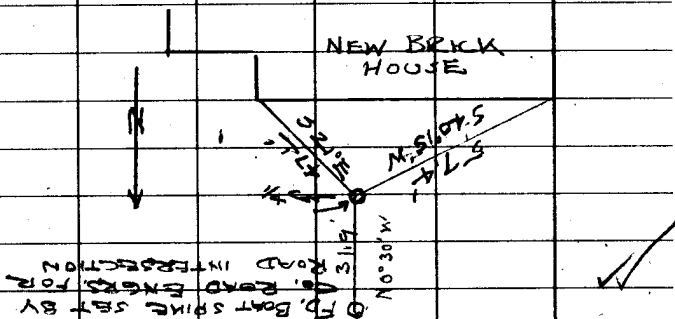

AFC

CS 49/21-56