

RENEW CC

5/1 T 245 R 7 W

FOUND - 42" NOW 48" FIR 386° E. 52.8'
 SHOWS GOOD BARK SCRIBING "45"
 42" NOW DOWN 48" FIR 310° W 19.8'
 BARK SLOUFFED OFF NO SCRIBING
 FOUND.

SET BRASS CAP AT CORNER, MAD.
 COUNTY SURVEYORS OFFICE 1960


5/1 T 245
 5/1 SA
 R 7 W
 T 245

NEW BTS.

12" R. FIR BEARS S 54° W 21.4'
 SCRIBED CC S 51° T 245 R 7 W 55 BT
 10" R. FIR BEARS N 39° W 9.6'
 SCRIBED CC S 51° T 245 R 7 W 55 BT. NO SUITABLE
 TREES NEAR TO SET

NOTE - COPY NOTES FOR THIS CORNER
 RECEIVED BY COUNTY AGROVEYOR
 DEPT. 1960 STATE SET FOR COR.
 # USED BY OTHERS BEARS S 54° W 21.4' 19.3

SET T 245-60

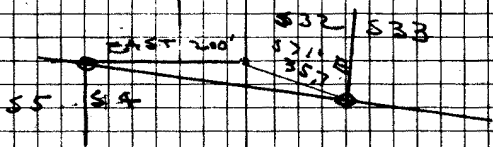

J. BYRON

DIETZGEN NO. 395-6