

Renew Closing Cor. of <sup>T235 S</sup> 51 | 56 T245 R578W.

Fd. County Brass Cap properly MKd as Recorded  
in Renew # 19 of T245 R8W. all it's down

& dead or gone completely we MK

New B's as follows —

8" W. F.R East 32<sup>8</sup> ft.

MKd "CC T245 R7W 56 CS BT "


6" D. F.R S, 53 ° W, 74<sup>2</sup> ft.

MKd, "CC 51 CS BT "

This cor. lies 30 ft South of  
Old Logging Road.

April 18, 1966

V.R.T.  
M.S.  
J.H.

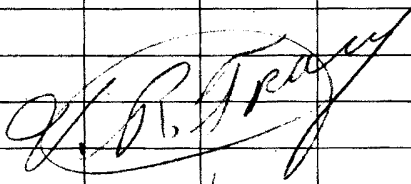

#10-T237  $\frac{36}{16}$

**FILED  
RECEIVED**

**APR 18 1966**

#135-T23-7  
#34-T23-8  
#34-R<sup>T23</sup>  
#98-T24-7

**COUNTY SURVEYOR  
DOUGLAS COUNTY, ORE**

\*✓

C.S. No. 49/71-58