


SEARCH FOR 1/4 COR. 18/17 T23S R5W

FOUND - NEITHER ORIG. BT. I DO FIND
3" PARTLY ROTTED FIR STUMP
SHOWS OLD SCRIBING 30 YEARS OLD
"BT" TRACKS SCRIBING FACES THUS

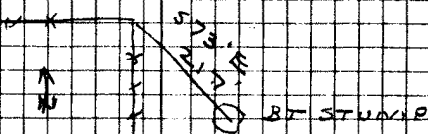

OCT 30-59
J. B.
M. G.
C. D.

DIETZEN NO. 385-5

FILED
RECEIVED

OCT 30 1959

COUNTY SURVEYOR
DOUGLAS COUNTY, ORE.

C. S. File No. 19/22 ^{FM}