


RENEW ^{29/25} 22/33 T 235 R SW

FOUND - ORIG. 16" NEW 20" DOWN F.
 BOTTED OAK N 82° E 25.9. I FIND CHIP
 OLD FACE SHOWING GOOD REVERSE
 SCRIBING BT" ORIG. 16" NEW DOWN F.
 DATED OAK (S 57 E 50.5) RECORD
 S 55 E 85.1 I FIND CHIP OF OLD FACE
 SHOWING GOOD REVERSE SCRIBING, ORIG.
 N W & SW B.T.S. NOT FOUND.

FENCES THUS

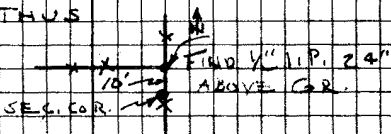

~~SAT BRASS CAP AT CORNER MKD
 COUNTY SURVEYORS OFFICE 1959~~

~~S 29/52 E
 S 32/53 T 235 R SW~~

VAR 20 1/2°

DEC 18-59
 J. B.
 M. G.
 C. P.

NEW BTJ.
 26" R. FIR BEARS S 76° W 53.8'
 SCRIBED S 32 T 235 R 5 W C S BT

4" R. FIR BEARS S 15 1/2° W 18.7'
 SCRIBED S 32 C S BT

NO SUITABLE TREES NEAR TO N W
 NE & SE

DIETZGEN NO. 3895-6

*

✓ C. S. File No. 49/42 1/2