

SEARCH FOR

32/33

T23S R5W


5

FILED  
RECEIVED

DEC 30 1959

COUNTY SURVEYOR  
DOUGLAS COUNTY, ORE.

DIETZGEN NO. 385-6

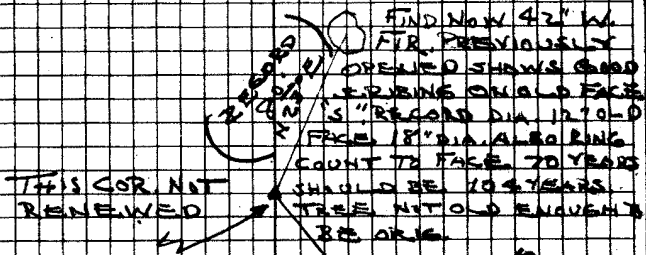

THIS COR NOT  
RENEWED

FIND NOW 42" W.  
FTR. PREVIOUSLY  
OPENED SHOWS GOOD  
RINGS ON OLD FACE  
5" RECORD DIA. 1270.0  
FACE 18" DIA. ALSO RING  
COUNT TO FACE 70 YEARS  
SHOULD BE 109 YEARS.  
TREE NOT OLD ENOUGH  
BE ORIG.

VAR 20 1/2°  
J.B.  
M.G.  
D.E. 23-59

✓ C. S. File No. 19/42