

T 22 S R 4 W

NOT FD.

1/4


S 21
S 28

FD. 16" CEDAR - SCRIBING
FACING SOUTH " 1/4 SBT."

NOT ORIG. BEARING TREE.

NO RECORD IN THIS OFFICE
OF ANY RENEWAL OF THIS
COR.

Milo E. Jeffrey

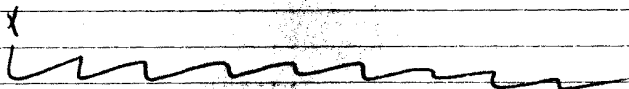

NOT RECORDED
RECEIVED 1/4 S/S
7/8

ORAL REQUEST FOR
RENEWAL BY MR. GLEN
COOKS

NO TRACE OF COR. OR
BEARING TREES FD.

Milo E. Jeffrey


CS 99142-65

Date: 9/14/62

Trp 225 Rge 4 W

Section 21

Mike & Betty

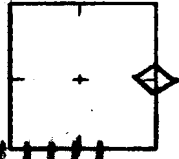

How was corner identified? Could not find corner.

Supposedly an iron pipe

Condition of corner: Was probably buried during road construction but shouldn't be under road.

Best route to reach corner: Cox Creek road for about 2 1/4 mi.

SEPT. 25, 1962
 DID NOT RENEW
 NO CR14, B.T.'s FD.
 NO RECORD OF
 RENEWAL IN
 CO. SURVEYOR'S OFFICE.

Other Remarks:

Brng. tree is in owners yard to right of house.

Quadrant	NE	NW	SE	SW
Species & Size	16" cedar			
Dist. & Bearing	?			
Condition of Scribe	Good			
Original or Resurvey?	probably orig.			
Appearance of B.T.	Poor			
Tags, Marks, etc.	Scribed			

← NOT ORIF. B.T. 9m. @

John H. Rice
Signed