

MAP
 SHOWING LOCATION OF
 RESIDENCE ON & BOUNDARIES OF
 LOT 9, BLOCK 2 CLOAKE'S FERRY IN
 THE CITY OF ROSEBURG, COUNTY OF
 DOUGLAS, STATE OF OREGON

SURVEYED DEC. 9, 1957


SCALE 1" = 40'

I HEREBY CERTIFY THAT I HAVE SURVEYED THE ABOVE DESCRIBED
 PROPERTY AND THAT THE IMPROVEMENTS SHOWN AND DESCRIBED HERE-
 ON ARE WITHIN THE PROPERTY LINES

James W. Byron
 JAMES W. BYRON
 DEPUTY COUNTY SURVEYOR



James W. Byron
 NOV 6, 1953
 JAMES W. BYRON
 303

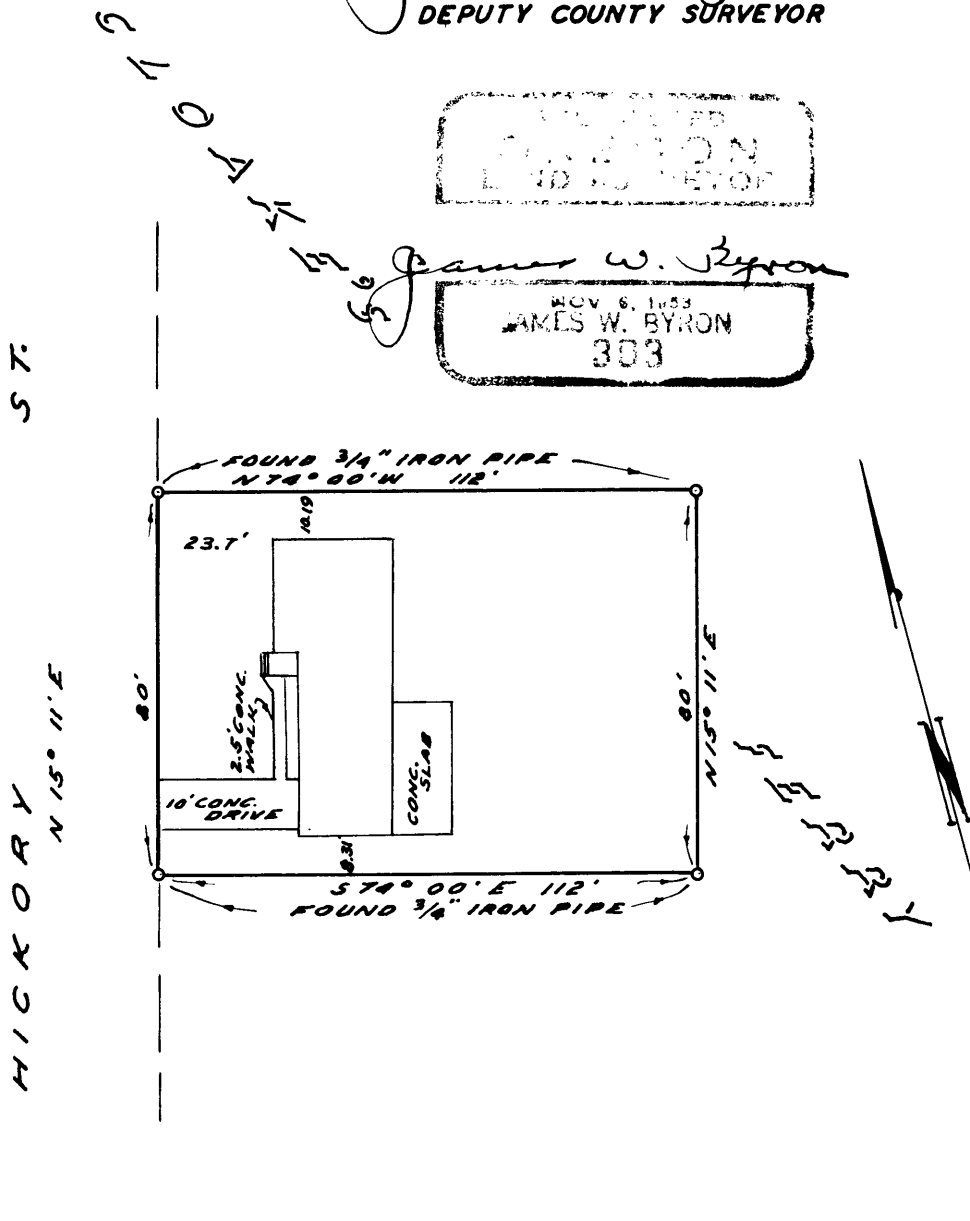

CS FILE FOLDER

CONTAINS

MORE

INFORMATION