

RENEW C C 12 T 305

RAW R3W

FOUND - ORIG. 14" N.W. 22" W. OAK
79° W 46' 10" I FIND GOOD SCRIBING
I ALSO FIND N.W. 36" FIR STUMP
I ALSO FIND BEARING OF OUT FOR
ORIG. N.W. BUT STUMP HAS BEEN
BADLY BURIED & PARTLY NOTED NO
SCRIBING FD.

SET BRASS CAP AT CORNER
MND. COUNTY SURVEYORS OFFICE
1958 C C

312 SET T 305


313 R 3W

RAW

NEW BT

10" W. OAK BEARS S 41° W 186°

SCRIBED C. C. 13 T 305 R 3W
C 5 BT

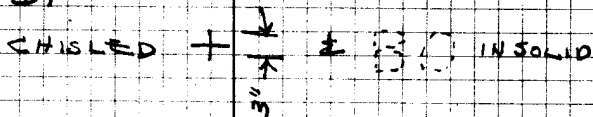

ROCK OUTCROPPING ON VERTICAL
FACE 12" ABOVE GROUND EXPOSED
LEDGE 3' X 3' X 3' FACES S 70° W
N 36° W 232'

DIETZGEN NO. 385-6

FILED

RECEIVED

JUL 31 1958

COUNTY SURVEYOR

DOUGLAS COUNTY, ORE.