


RENEW ²¹²²₂₈₂₇ T26S R3W

FOUND - ORIG. 12" NAW 26" W. OAK
 DOWN & PARTLY ROTTED N 20° W 316.8'
 PREVIOUSLY OPENED SHOWS GOOD
 SCREWING "5" ORIG. 12" NAW 24" B. OAK
 NOW SNAG N 5° E 666.0' I OPENED
 SHOWS GOOD SCREWING "5 1/2" I ALSO
 FIND BADLY BURIED LAUREL SNAG THAT
 CHECKS TO 2" FOR ORIG. SW BT.

NOTE - I FIND BEARINGS & DIST.
 FOR ORIG. B.T.S DO NOT CHECK RECORD.
 THIS CONDITION IS FOUND RELATIVE TO
 POSITION OF SEC. COR.
 SCR. IS 90' EAST OF WIRE FENCE

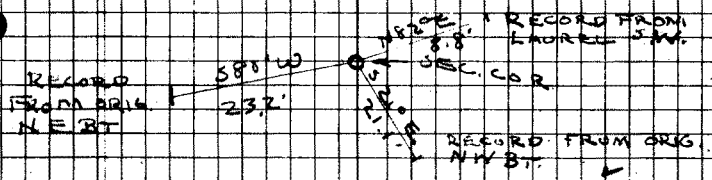

SET BRASS CAP AT CORNER MKD.

521526 - 26S R3W COUNTY SURVEYORS
 228 1/2 OFFICE 1959

NEW B.T.S

29" CEDAR BEARS N 11° E 16.7'
 SCRIBED 522 T26S R3W CS BT
 15" FIR BEARS N 66° W 25.3'
 SCRIBED 521 T26S R3W CS BT

7" CEDAR BEARS S 73° W 10.6'
 SCRIBED 528 T26S R3W CS BT

28" CEDAR BEARS S 82° E 19.2'
 SCRIBED 527 T26S R3W CS BT

VAR 20 E

SEPT 15-59
 J.B.
 M.S.
 C.P.

✓ C.S. File No. 4948-4

DIETZEN NO. 385-6