

REN. T 23 S R 8 W COR. 22/23
SECS. 27/26

FIND SANDSTONE ROCK SLAB
14" X 10" X 1 1/4" WITH 2 NOTCHES ON
PRESENT SOUTH FACE. STONE HAS
APPARENTLY SLID DOWN HILLSIDE ABOUT
16" TO 18" FROM CORNER.

FD ROTTEN FIR SNAG N 26° E
48 1/2 FT. SCRIBING VISIBLE "23 R 8
S 2" ON REMAINING PORTION OF OLD FACE.

FD. ROTTEN FIR SNAG S 75° E
19 1/2 FT. SCRIBING VISIBLE ON REMAINING
PORTION OF OLD FACE "R 8 W"

FD. FIR TREE (ALIVE) (NOW 48" DIAM.)
S 25 1/2° W 91 1/2 FT. SHOWS GOOD SCAR.

FD. STUMP HOLE WITH YOUNG MAPLES
AROUND IT N 30° W 70 1/2 FT.

AT COR, SET IRON PIPE WITH
BRASS CAP MKD. "COUNTY SURVEYOR'S
OFFICE 1962 T 23 S R 8 W S 22/S 23"

SET ROCK WITH NOTCHES ALONG SIDE. S 27/S 26

BLAZE & SCRIBE NEW TREES: 4/46

30" DOUGLAS FIR N 8° W 29 1/2 FT.
MKD. "T 23 S R 8 W S 22 CS BT"

8" DOUGLAS FIR N 32° E 22 1/2 FT.
MKD. "T 23 S R 8 W S 23 CS BT"

16" DOUGLAS FIR S 8° W 41 1/2 FT.
MKD. "T 23 S R 8 W S 27 CS BT"

9" DOUGLAS FIR SOUTH 37 1/3 FT.
MKD. "T 23 S R 8 W S 26 CS BT"


+ * *W. E. Galtrey*

AUG. 24, 1962
M.G. - V.T. - M.S.

C.S. File No. 89-29-11

Section 26 Twp T23S Rge R8 W

Date: 8/9/62

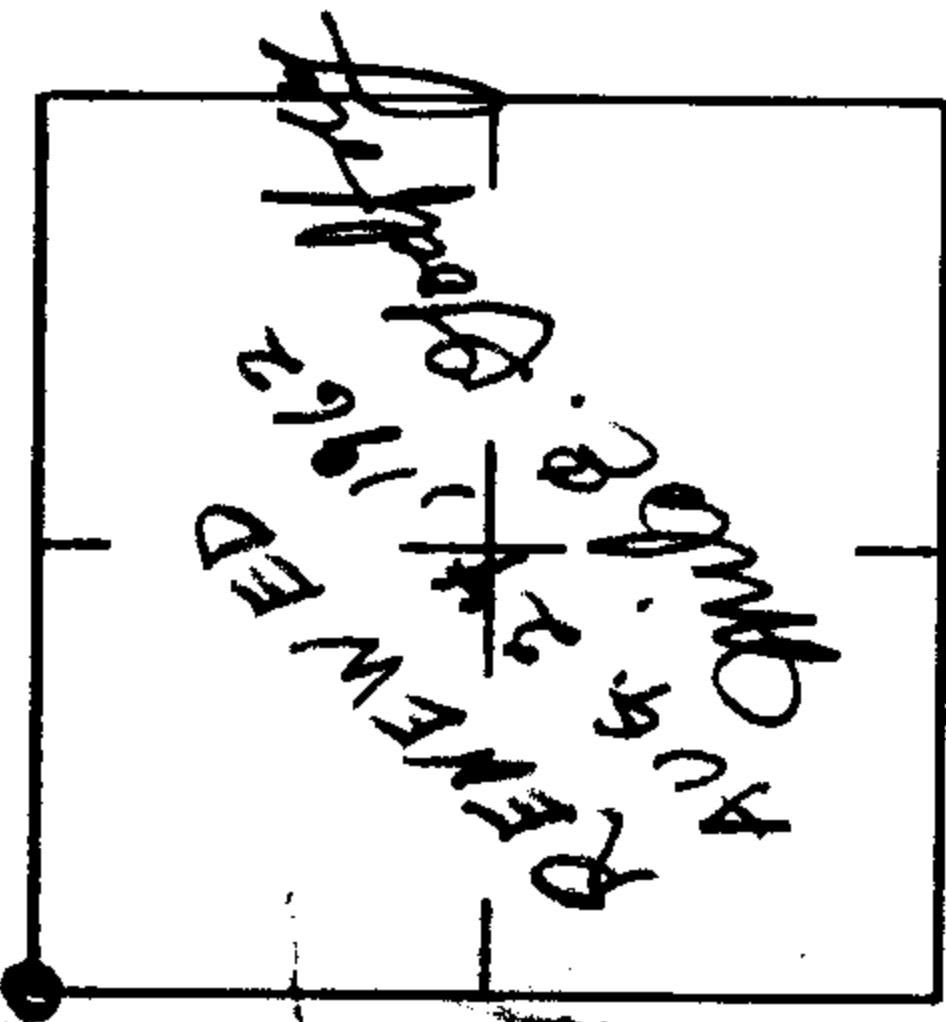

How was corner identified? B.T. with scribe

Showing @ Stone with 2 Notches on South side

Condition of corner: Next to an old up root

End Stone w/ 2 Notches.

Best route to reach corner: Upper Wagoner

Creek Road in. Sec 26 - go out Ridge and follow in.

Quadrant	NE	NW	SW	SE
Species & Size	Fir 24'	No find	Fir 48"	None
Dist. & Bearing	N 26° E 7 fms		S 25 1/2° W 13 fms	
Condition of Scribe	Visible		gone	Part Scribe
Original or Resurvey	Org.		orig	
Appearance of B.T.	Badly Decayed		Standing Tree	
Tags, Marks, etc.	None.		at least	

Other Remarks:

R.P. Corner Small

Hemlock 72 North

Long yellow & orange

Ripsh. Should be

Re-set

J.D. Lambert

Signed

CS 49149-n