

RENEW 36/31 T 285
116 T 295


R7W R6W

FOUND - ORIG NW BT. I FIND 24' OAK
SNAG OPEN & FIND GOOD SCRIBING 'S 36
BT. I DO NOT FIND OTHER OLD BT'S. I
DO FIND PARTLY ROTTED WOOD STUMP
THAT WAS SPELLED YEARS AGO NO SCRIBING
FOUND TODAY. RECORD S 26' E 51' W 396'. I
FIND TO BE S 26' E 51' W 396'. I BELIEVE
THESE ARE THE BT'S FOUND BY FORTSIN
1928. ALL OF FORTSIN'S BT'S HAVE
BEEN CUT & NO SCRIBING CAN BE
FOUND ON ANY STUMP EXCEPT I DO FIND
GOOD SCRIBING ON SW BT WHICH IS IN
GLIDE AREA. I FIND OUT OF POSITION
I FIND 18" CUT TREE IN GLIDE AREA
SCRIBED T 285 R 7W. THE EVIDENCE
I FIND OF FORTSIN'S BT'S DO NOT AGREE
WITH ORIG. TOP DO THEY CORRECT TO A
COMMON CORNER. THEREFORE I USE THE
ORIG. RECORD BEARING & DISTANCE FROM
NW BT TO SET COR. N 71/4° W 396'
SET BRASS CAP AT CORNER MKD.
COUNTY SURVEYORS OFFICE 1957

536/531 T 285

51/56 T 295

R7W R6W

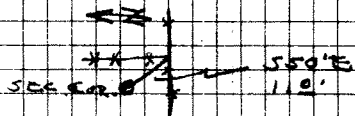

NEW BT'S

15" R. FIR BEARS N 27° E 556'
SCRIBED T 285 R 6W S 31 C S BT

6" R. FIR BEARS N 28° W 47.9'
SCRIBED T 285 R 7W S 36 C S BT

1 1/2" R. FIR BEARS S 54° W 124.6'
SCRIBED T 295 R 7W S 1 C S BT

NO TREES NEAR TO S E

VAR 20 1/2°

NOV. 13 - 58
U.B.
N.G.
S.B.

C.S. File No. 49/50-1

DIETZGEN NO. 385-6