

RENEW  $\frac{718}{1817}$  T285 R6W

FOUND - THREE ORIG. BTS.

ORIG. 26" NOW 40' ROTTED STUMP

N 65° W 37.0 FIND GOOD SCRIBING "BT"

ORIG. 10" NOW 30" W. OAK N 42 1/2° E 36.3'

CHECKS BEARING & DIST. ORIG. 12" NOW

30" W. OAK SHOWS OLD SCAR I DO NOT

OPEN 56 1/4 80' I FIND NO TRACE

OF ORIG. SW BT.

SET BRASS CAP AT CORNER MKD.

57 | 58 T 285 R 6W COUNTY SURVEYORS

518 | 517 OFFICE 1958


NEW BTS.

10" W. OAK BEARS S 61 1/2° W 71.5'

SCRIBED S 18 T 285 R 6W CS BT

12" W. OAK BEARS N 63 1/2° W 11.9'

SCRIBED 57 T 285 R 6W CS BT

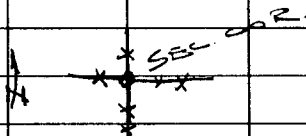

12/1958

CS 49/50 - 29

✓