

RENEW $\frac{1}{4}$ COR $\frac{7}{18}$ T 285 R 7W

FOUND - BOTH BT'S AS RECORDED BY BOYER NW BT DOWN. WE DO NOT FIND I.P. AT COR.

SET BRASS C.M. AT CORNER
MND. COUNTY SURVEYORS OFFICE
1961 $\frac{1}{4}$ $\frac{57}{18}$ T 285 R 7W

NEW BT'S.
12" CEDAR BEARS N 59° E 30'
SCRIBED $\frac{1}{4}$ S 7 K S BT.

10" W. FIR BEARS S 51° W 28.3'
SCRIBED $\frac{1}{4}$ S 15 C S BT.

*

✓✓


RENEW $\frac{1}{4}$ COR $\frac{36}{1}$ T 285 R 7W

FOUND - BOTH BT'S RECORDED BY FOP. 18" NOW 20" FIR STUMP N. FOP NOT NICE. SHOWS GOOD BARK SCRIBING "BT" 16" NOW 18" FIR STUMP S 47° W 150' SHOWS OLD AXE WORK CUT TOO LOW NO SCRIBING FOUND.

SET BRASS C.M. AT CORNER
MND. COUNTY SURVEYORS OFFICE
1961 $\frac{1}{4}$ $\frac{536}{51}$ T 285 R 7W

NO TREES NEAR FIR BT'S.

TO ANGLE IN FENCE THUS

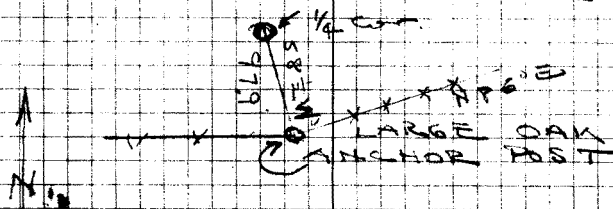

May 1961

✓✓✓

C.S. File No. 49/50-58

*

DIETZGEN NO. 385-B