


RENEW SEA COR. $\frac{3}{2}$ 10/11 T 295 R6W

FOUND - 3 OF THE ORIG BITS
ALL CHECK FOR BEARING & DINT.
THE ORIG. N W BT NOW 30" B.O.
IS BLIVE. SHOWS OLD SCAR I DO NOT
OPEN.
THE ORIG. S W BT NOW 36" SNAG
SHOWS OLD SCAR I DO NOT OPEN.
THE ORIG. 4" W.O. NOW 22"
N 73 1/2° E 46.9' I OPEN & FIND GOOD
SCRIP "BT"

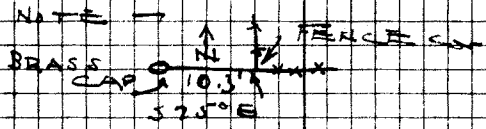

SET BRASS CAP AT CORNER MND.

3315 T 295 R6W COUNTY SURVEYORS
510 J 11 OFFICE 1957.

DIETZEN NO. 385-6

NEW BITS
8" W.O. BEARS N 83° W 340' EXHIBIT
T 295 R 6 W S 3 CS BT
90" W.O. BEARS S 35° W 753'
T 295 R 6 W S 10 CS BT
6" B.O. BEARS S 71° E 638'
T 295 R 6 W S 11 CS BT
12" LAUREN N 79° E 90'
T 295 R 6 W S 2 CS BT

VAIR 20 1/2"

DEC. 27-57
J.B.
M.G.
S.B.

✓ Dec 1957

C.S. File No. 49/32