


RENEWAL N.E. COR. D.L.C. # 56
T 27S R 6W JAN. 3, 1958

SEC. 13
BALM TREE
2' S.
TO
FACE OF
TREE

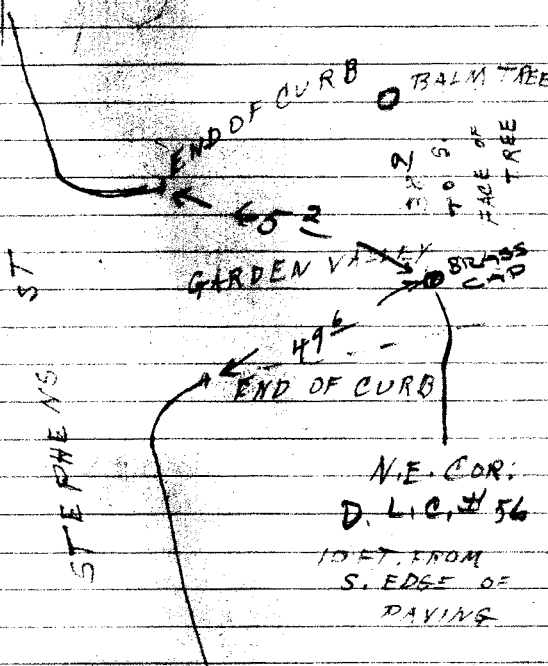

FD 1" AXLE SET IN CONCRETE
SET 1" PIPE WITH BRASS CAP
STAMPED "COUNTY SURVEYOR'S
OFFICE 1908 T 27S R 6W
N.E. COR. D.L.C. 56"

J. BYRON
M. GODFREY
S. BILOW

C.S. File No. 49/557