


~~HOWEVER~~ 11/17 T275 R6W

FOUND - ALL OF CROCKERS BITS  
 16" NW 24" FIR STUMP S 51° E 129'  
 H. 12" NW 6" LAUREL S 61 3/4° W  
 4 1/2" SHOWS SCRIBEL MARKS  
 10" NW 18" B. OAK N 32 3/4° E 413  
 H. 14" NW 24" B. OAK  
 N 86° E 43.8" SHOWS GOOD SCAR  
 H. DO NOT OPEN.

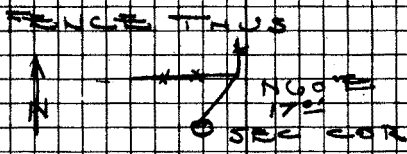

SET BRASS CAP AT CORNER MKD.  
 COUNTY SURVEYORS OFFICE 1960

6 1/2 5 7  
 5 1/2 5 20 T275 R6W

NEW BITS

6" R. FIR BEARS N 13° E 19.5'  
 SCRIBED S 17 T 275 R6 W C.S.B.

10" R. FIR BEARS S 58 1/2° E 412'  
 SCRIBED S 20 T 275 R6 W  
 C.S.B.H.

VAR 20 E AUG 16 - 1960  
 J. B.  
 M.G.  
 C. P.

DIETZGEN NO. 385-6