

DIETZGEN NO. 385-6

SURVEY M. B. 257/320 DEEDS

CRUS REYNOLDS - 1375 KESEY RD.

C. S. File No.

49/58

5

65°

4 A

180°

50°10' W

BRASS CAP
VETS

176°55'
35°28' L

8.70

3

58°38' W

208.75

2

RECORD 552.18

302.35

1

32.28


58°30' W

BRASS CAP
VETS.

DIETZGEN NO. 385-6

NOT FOUND IN DEEDS
NOT FOUND IN DEEDS

WEST LINE
OF VET'S

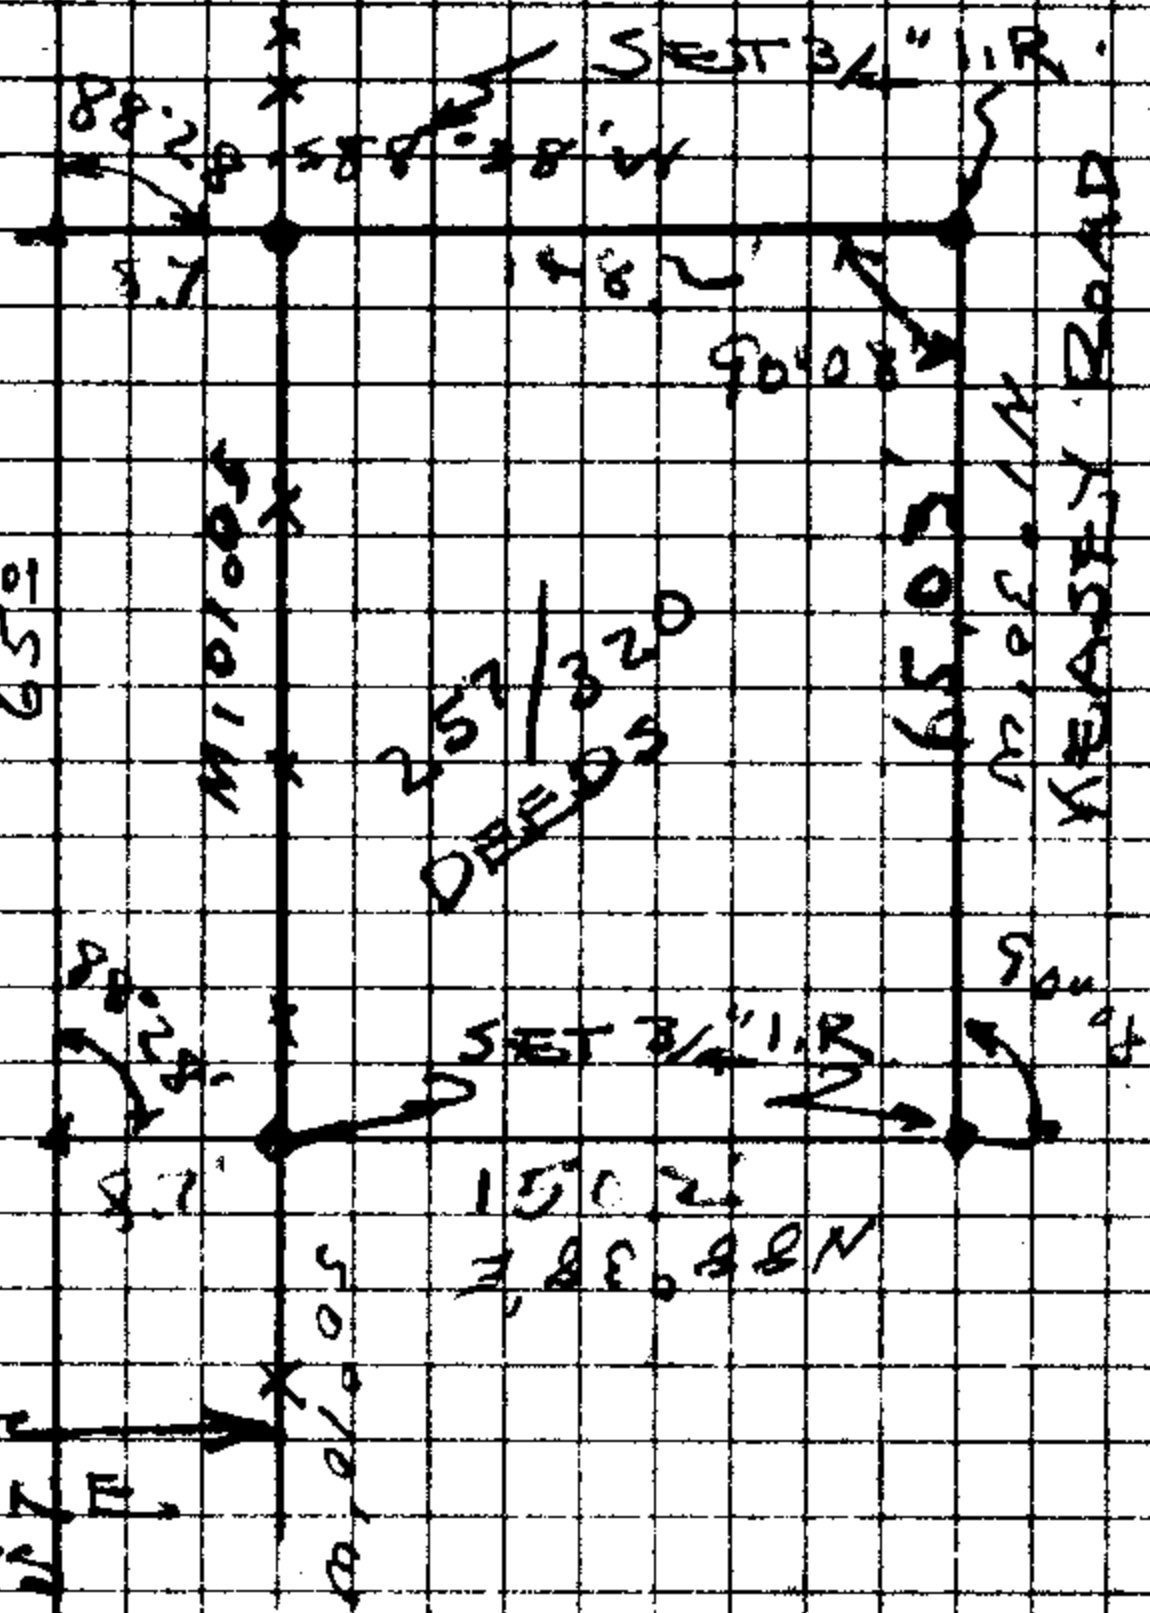

JAN. 14 - 58
J. BYRON
M. GODFREY
J. BILLOW

C. S. File No. 49/58


150.2
 87

 158.9

N 5 1/3 20

Deeds.

Keasey

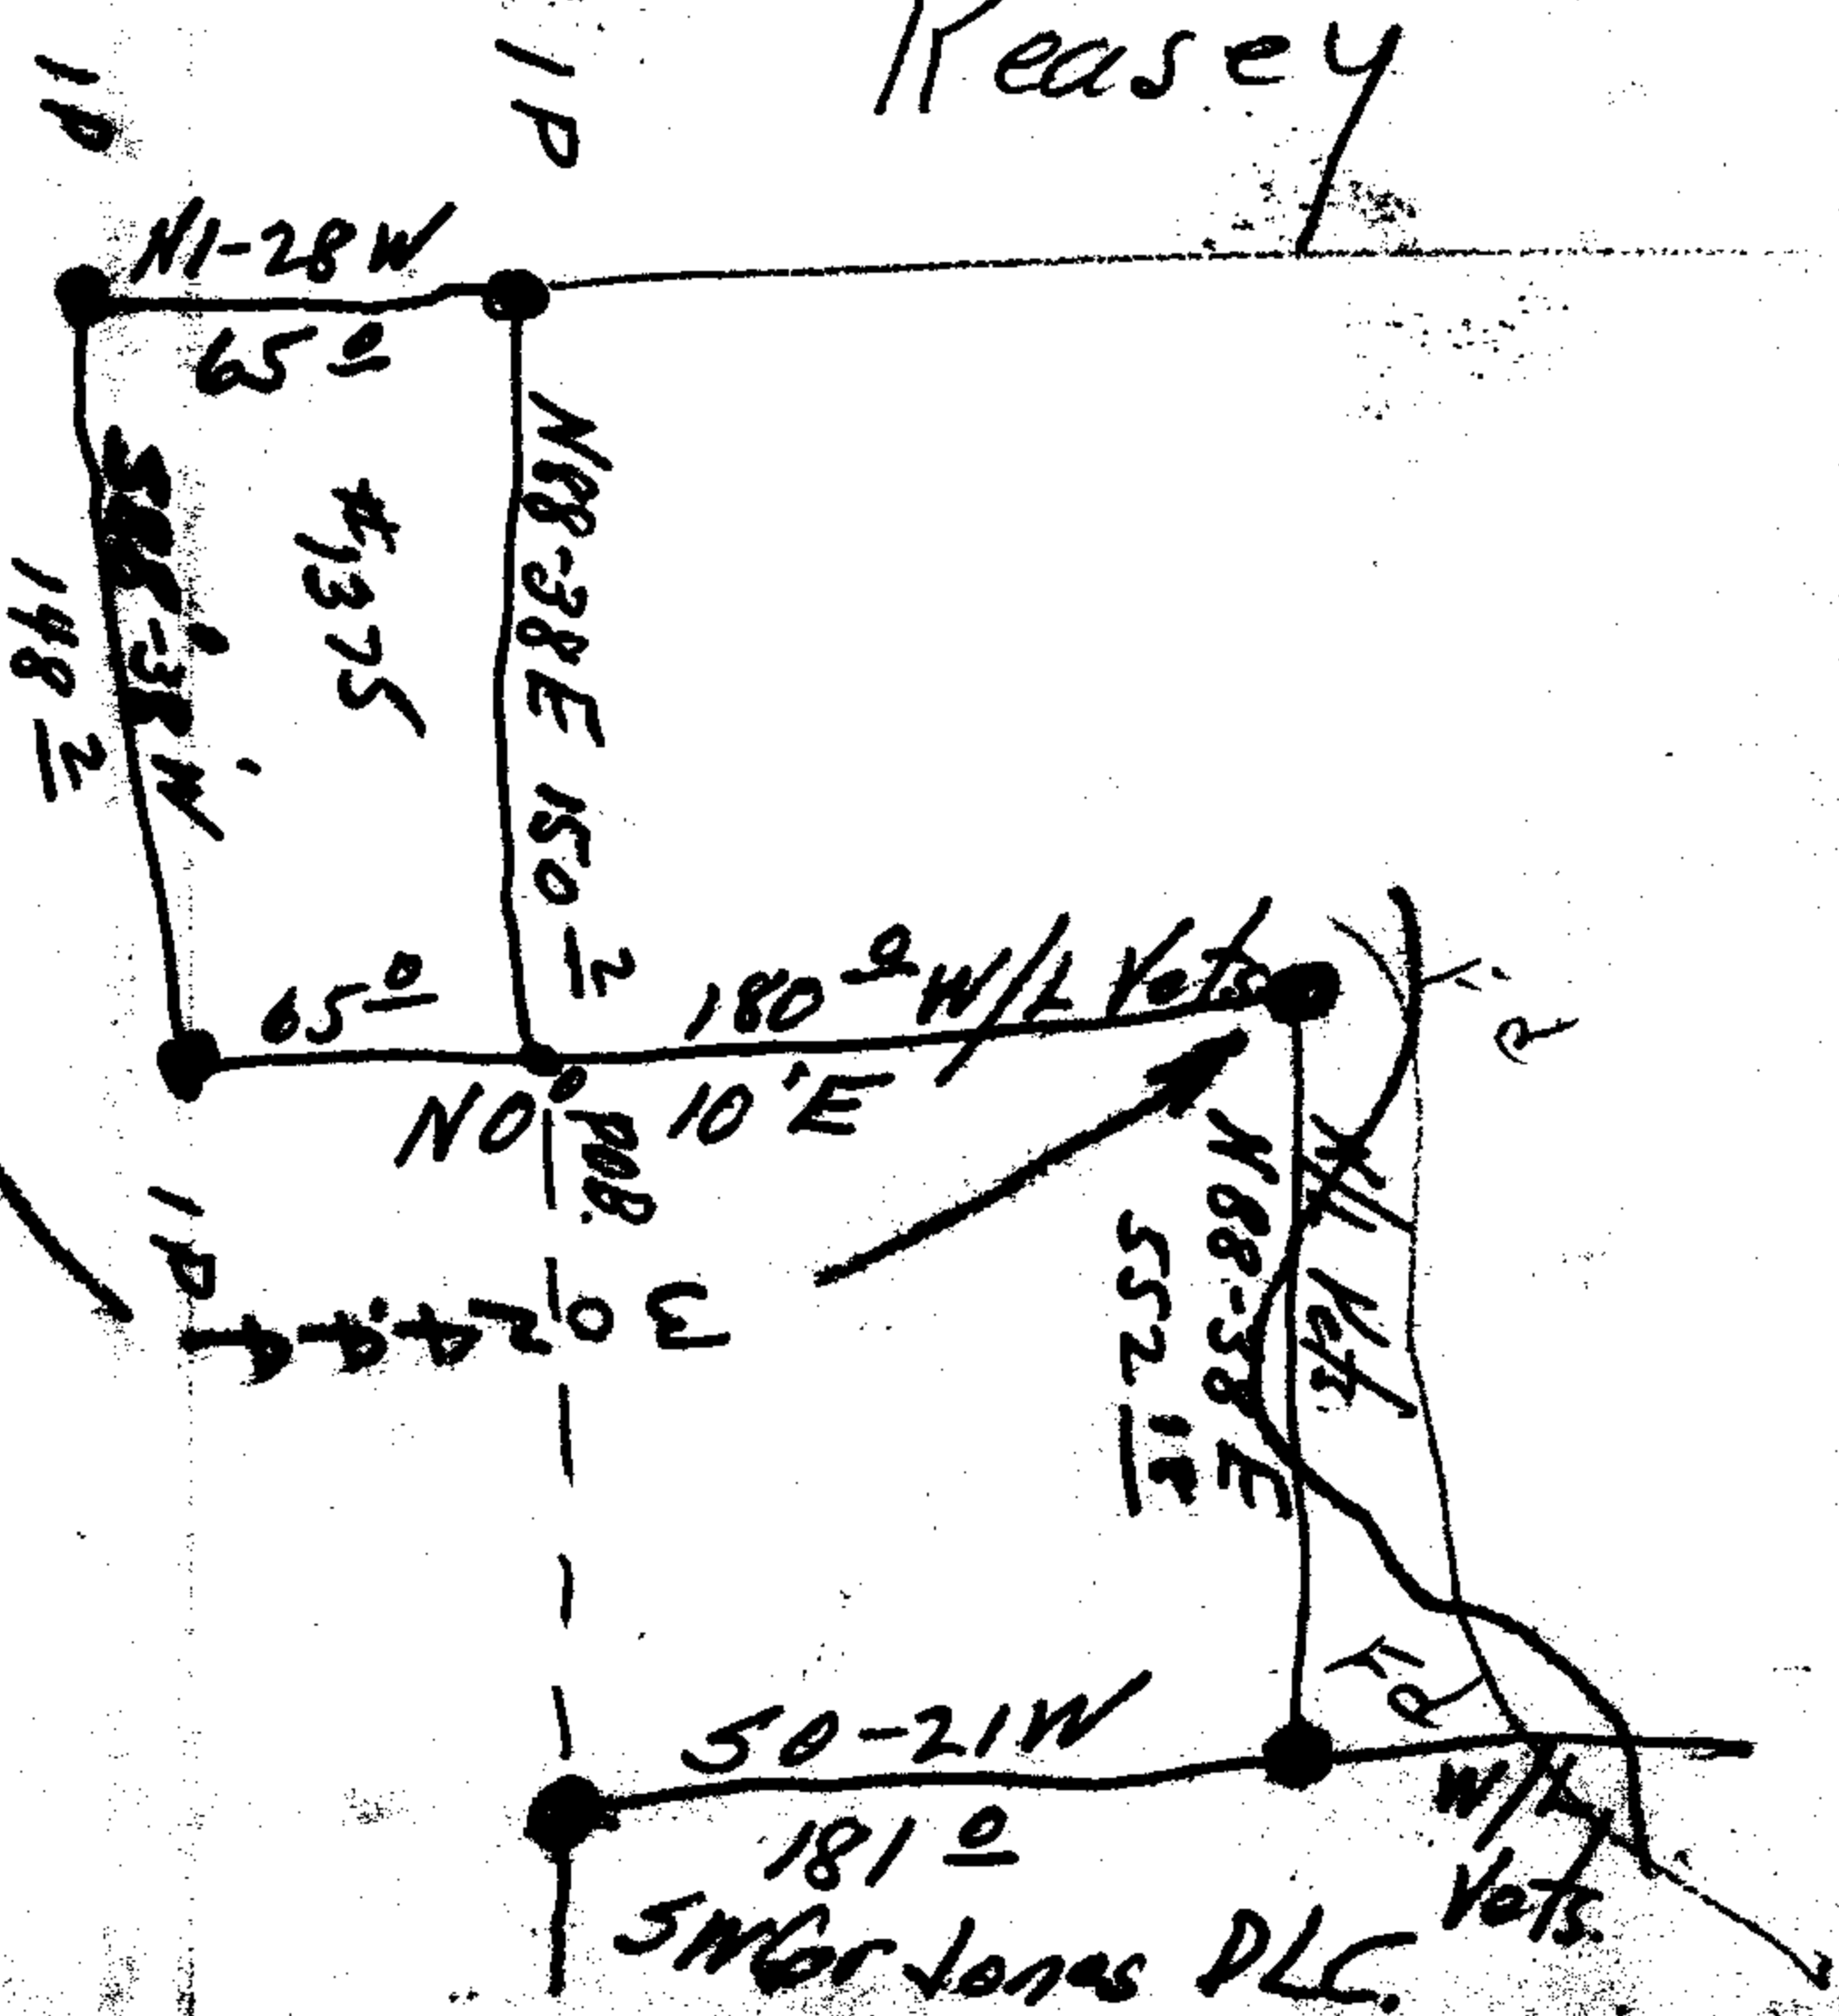

CS FILE FOLDER

CONTAINS

MORE

INFORMATION