

RENEW SEC. CAP. 31/32 T225  
RSW 6 T235

FD - 8" NAW 19" R. FIR  
N 75° 20' E 28' IF OPEN UPPER END  
FIND GOOD SCRIBING "WS" THIS  
RECORDED AS RENEWED 1901 BY  
RING COUNT IT WAS SCRIBED  
ABOUT 1928. ALSO THE TREE WAS  
12" WHEN SCRIBED (RECORD 8)  
I ALSO FIND ROTTED BASE OF  
FIR THAT CHECKS BEARING & DIST  
FOR NUB BT I FIND UPPER SECTION  
OF OLD ROTTED & SCRIBED TAKE  
ON GROUND.

SET IRONS CAP AT COR. MND  
COUNTY SURVEYORS OFFICE RSW


5 31 | 5 32 T225 RSW  
56 T235

NEW BTS.

10" R. FIR BEARS N 11° W 85'  
SCRIBED 5 31 T225 RSW CS BT

20" R. FIR BEARS N 74° E 42'  
SCRIBE 5 32 T225 RSW CS BT

16" R. FIR BEARS S 44° E 36'  
SCRIBED 5 6 T235 RSW CS BT

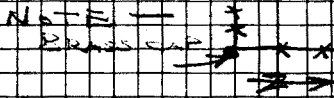

NO TRACE OF ORIG. BTS FD.

3/1950

C.S. File No. 49/59

DIETZEN NO. 385-6