

FOUND ONLY  
T 22 S R 4 W

28 | 27  
33 | 34

FD. 2" SQUARE SCRIBED STAKE.

FD. 58" DOUG. FIR N 10° E  
178 1/2 FT. - BARK SCRIBING VISIBLE.

FD. 33" WHITE OAK N 13° W  
129 1/2 FT. - 2 SCARS VISIBLE

FD. 26" WHITE OAK S 13° W  
36 1/2 FT. - AXE SCAR PLAINLY VISIBLE.

FD. 24" BLACK OAK S 51° E  
120 1/2 FT. - SCRIBING VISIBLE ON  
NOT COMPLETELY COVERED SCAR.

PIECE  
OF  
WOOD

FD. BADLY ROTTED OLD OAK  
STUMP S 69° E 183 1/2 FT. - NO  
MARKS FD. - TOO BADLY ROTTED.  
- (POSSIBLE ORIG. B.T.)

FD. REMNANTS OF OAK TREES -  
DOWN & BADLY ROTTED - TO N.E.  
& N.W. - WHICH APPROXIMATELY FIT  
FOR BEARING & DIST. FOR 2 ORIG.  
B.T.'S - NO MKS. FD. - TOO FAR  
GONE.

FILED DID NOT RENEW. ✓  
No Record of MAY 14, 1963  
RECEIVED RENEWAL M.G.

MAY 14 1963 V.T.  
M.S.

COUNTY SURVEYOR  
DOUGLAS COUNTY, ORE.

C. S. File No. 49/42

M 4-51 mentions Cor found

FOUND-DUG OUT.

1/4" I. PIN PUT IN BY  
MILLER WHEN THIEL  
RENEWED CORNER.

RAY  
MILLER

SAID

THIEL

CHOPPED IN ID WAS

AGOI <sup>WHEN he was present</sup> & MILLER

WENT OUT & FO.

THIS PART OF STUMP

WITH SCRIBING

8/7/63.


BILL WILT.

Section 27

Twp 22

Rge -4

Date: 5-1-63

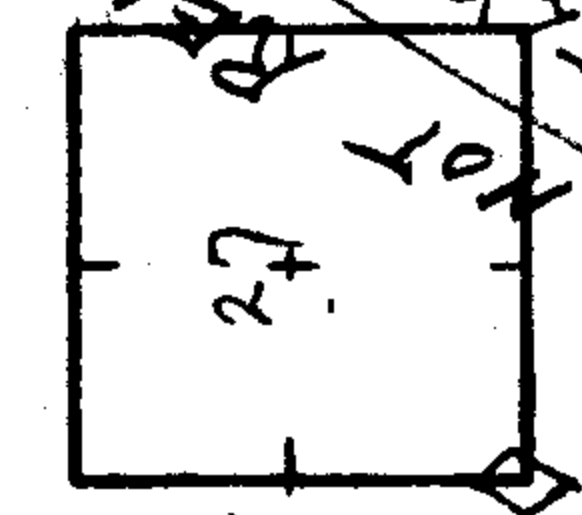

How was corner identified? 2x2 wooden stakes in SW quad

with apparent face in SW quad

condition of corner:

APPARENTLY RENEWED  
ABOUT 1950 - 1951  
FINDING RECORD  
DID NOT APPEAR IN 1950 - 1951 RECORD

Best route to reach corner: Scotts Valley Rd - see Mr

MILLER FOR KEY

REN, AUG 9, 1963

Other Remarks:

Quadrant	NE	NW	SE	SW
Species & Size				
Dist. & Bearing				
Condition of Scribe				
Original or Resurvey				
Appearance of B.T.				
Tags, Marks, etc.				

~~C.S. File No. 79/52-37~~

Robert Forsy

Signed

