

T 22 S R 4 W

NOT FD. -  $\frac{1}{4}$   $\frac{59}{516}$

PO. HAINES "T" IRON & CAP  
DRIVEN ALONGSIDE  $\frac{1}{2}$ " IRON PIPE

FIR TREE (NOW 48" DIAM.) -  
RECENT BLOWDOWN - BEARS  
N 32° W 19 FT.

BARK SCRIBING ON FIR " $\frac{1}{4}$  59  
BT 363" - ALSO CRUISER'S  
MKS. - SOME FAIRLY OLD.

HAD BEEN CUT OPEN 5 TO  
10 YRS. AFD TO AN OLD  
INJURY - NO EVIDENCE OF  
SCRIBING, & NO OLD AXE MKS. -  
NO EVIDENCE VISIBLE THAT THIS  
WAS ORIG. B.T.

NO NEW B.T.'S FD. - NO  
RECORD OF RENEWAL.

JULY 8, 1963

*Hubert C. Madge*  
M.G.  
M.S.


DOUGLAS COUNTY  
SURVEYOR  
DOUGLAS COUNTY ORE.

C.S. File No.

49/59-39

Section 9 Twp 22 Rge 4 Date: 6-4-63

~~63-55/59~~ ON 11 19

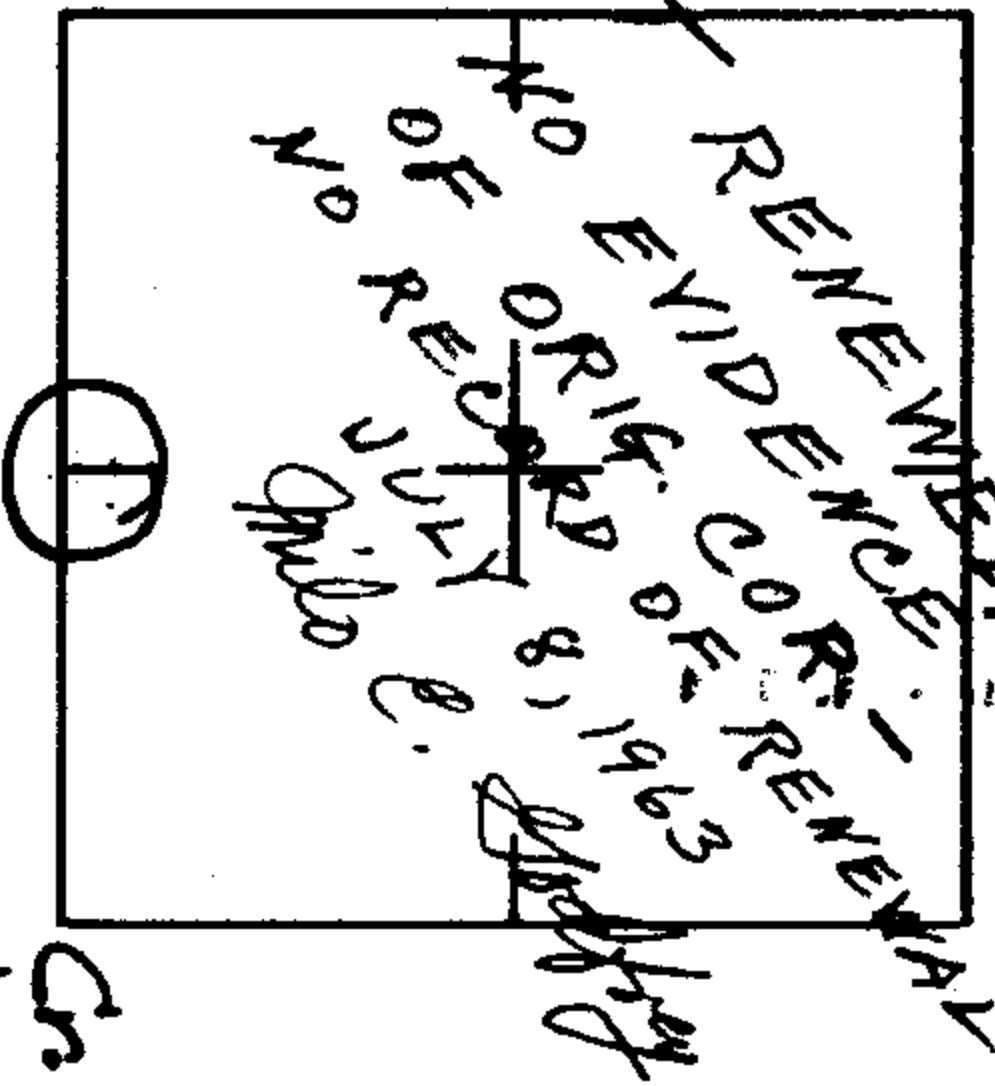

How was corner identified? W. HINES T-110N 239.

Condition of corner: good

Best route to reach corner: Take Highway 99 to

Cr turnoff go to Curtiss Cr. go through Jackson's place it's a walking shoe through

Other Remarks:

Quadrant	NE	NW	SE	SW
Species & Size			44" DE	
Dist. & Bearings			19 FT. S32°E	
Condition of Section				
Original or Resurvey			ORIGINAL	
Appearance of B.T.			DOWN	
Tags, Mark etc.				

E. J. Ward

Signed

23