



REN. T 23 S R 10 W  $\frac{1}{4}$  S 12  
S 13

FD. REF. HUB - ALSO TACK IN STAKE  
NAILED TO 60" FIR - AS MKD. ON  
REFERENCE NOTES. *REN. #30*

MEASURED OUT ON LINE 109.51 FT.  
(51.35 -  $19^{\circ}37'$  = 48.37 TO HUB SET),  
(4.03 -  $25^{\circ}07'$  = 57.98 TO TACK IN ROAD)  
& 3.16 LEV. TO COR.

BOTH  
S.E. TREES NOW GONE. - ORIG. S.W. TREE  
NOW GONE. - STUMP OF ORIG. N.W. TREE  
FD., BUT NO SCRIBING.

AT COR. SET IRON PIPE WITH  
BRASS CAP MKD. "COUNTY SURVEYOR'S  
OFFICE 1964 T 23 S R 10 W  $\frac{1}{4}$  S 12"  
S 13"  
CAP SET LEVEL WITH PRESENT GROUND  
SURFACE, APPROX. 3 FT. N.W. OF  
N.W. EDGE OF TRAVELED PORTION  
OF COUNTY ROAD, AS IT EXISTS  
AT PRESENT.

IN EXCAVATING FOR SETTING CAP  
FD. IRON ROD SET BY FEAR 28"  
BELOW PRESENT GROUND SURFACE. -  
SET CAP OVER IRON ROD.

BLAZE & SCRIBE NEW TREES:

11" DOUG. FIR S  $76^{\circ}$  W 61  $\frac{1}{2}$  FT.  
MKD. "  $\frac{1}{4}$  S 13 CS BT "

12" MAPLE N  $77\frac{1}{2}^{\circ}$  W 25  $\frac{1}{2}$  FT.


MKD. "  $\frac{1}{4}$  S 12 CS BT "

JUNE 1, 1964

*Phil C. Godfrey*  
M.G. 549/60

REN'S  
#30  
+ \* ✓

Section 13 Top 23 S Rge 16 Date: 4-20-64

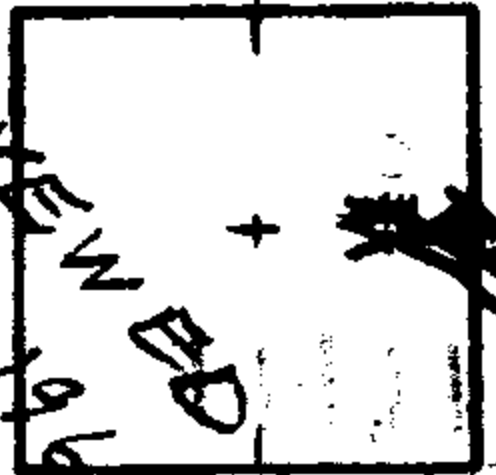

RENEW 11' x 11'  
 JUN 8  
 OMB E. Shoff

How was corner identified? Bearing tree top

Condition of corner: poor

Best route to reach corner: Mill creek Road and

about 1/4 of a mile from Rock House. The bearing tree is on the outside of the road.

Other Remarks:

Quadrant	NE	NW	SE	SW
Species & Size				
Dist. & Bearing				
Condition of Scribe				
Original or Replica				
Appearance of B.T.				
Tags, Markings, etc.				

Dimensioned by Billie  
 R.I. M. Coe

42/60