


BENCH COR. 23 T 275 R 5 W
 26
 FOUND - ORIG. 12" NOW 35" OAK
 FOUND. I OPEN AT TOP OF CUT
 FIND SCRIBE MARKS N 51° E 179'
 ORIG. 10" NOW DOWN & ROTTED
 OAK I FIND GOOD SCRIBE MARKS
 "S" S 23° W 179'

NOTE - COMPASS OFF ABOUT 60°
 HERE. USED WELFA L AM COR.
 1/4 COR ONE MILE NORTH. WHICH
 CAN BE SEEN FROM HERE.
 FENCE COR. THIS.

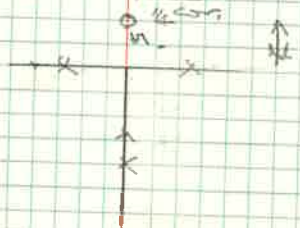


SET BRASS CAP AT CORNER MKD.
 COUNTY SURVEYORS OFFICE 1960
 1/4 323 T 275 R 5 W
 1/4 326

NEW STS.

10" W. OAK BEARS S 17° E 178'
 SCRIBED 1/4 S 26 CS BT

18" W. OAK BEARS N 84° E 119.5'
 SCRIBED 1/4 S 23 CS BT

JAN 22-60
 J.B.
 M.G. VAR. 20°
 C.P.

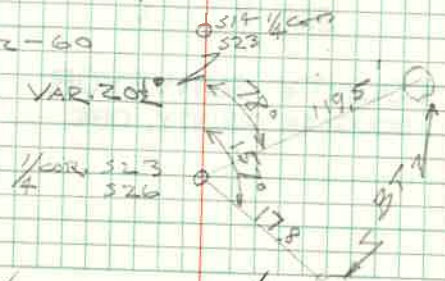

DIETZGEN NO. 395-6

