


RENEW $\frac{1}{4}$ Sec 31 T28S R5W

FOUND - 20' NW
WE OPEN & FIND BRASS CAP DESCRIBING
"1/4" NE DO NOT FIND NW
"1/4" NE ALSO FIND BRASS CAP
IN N 1/2 NE BRASS CAP N 61° E 4'

SAT BRASS CAP AT COR. MADISON COUNTY
SURVEYORS OFFICE # 1561 1/4 S31
T28S R5W 58

NEW BTS.
16' LAUREL BEARS S 13° W 27.3
SCRIBED $\frac{1}{4}$ SEC CS BT

9' LAUREL BEARS N 29 1/2° E 88
SCRIBED $\frac{1}{4}$ SEC CS BT

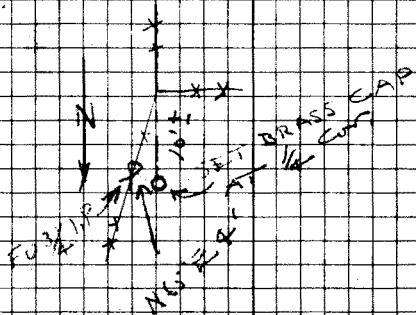

OCT. 23 - 1961
J. B.
D. M.
J. P.

FILED
RECEIVED

OCT 23 1961

COUNTY SURVEYOR
DOUGLAS COUNTY, ORE.

C.S. File No. 49/64-23

DIETZGEN NO. 385-6

+* O ✓