


RENEW 33/34 T275 R5W

FOUND - ORIG. 10" NOV 13 0" S. 24"
N 51° E + 2.0" DASHED DOUB SCAR
DO NOT OPEN, WE ALSO FIND
PIPE AT C.E.S. COR. AND
BOTH BITS AS RECORDED 1/3 BY BREAK

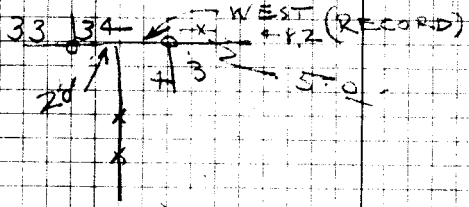

SET BRASS CAP AT COR. MKD.
COUNTY SURVEYORS OFFICE 1961

533 534 T275 R5W
T285

NEW BITS.
16" R.F.R. BEARS N 37° W 92'
SERIES 533 T275 R5W CS BT

Nov 3, 1961

FILED
RECEIVED

NOV 7 1961

COUNTY SURVEYOR
DOUGLAS COUNTY, ORE.

+ * 100

C. S. File No. 19/64-30

DIETZGEN NO. 385-6