

R6W R5W

RENEW 1/4 COR. 12 17 T28 S

FOUND - ORIG. 11" NOW 25" W. OAK
BPP 27.2' W/E OPEN & FIND
GOOD SCRIBING 'S'. ORIG. 53 3/4' E
BT NOT FOUND.


SET BRASS CAP AT CAR. MINN.
COUNTY SURVEYORS OFFICE 1961
1/4 S 12 157 T28 S
R6W R5W

NEW B.T.S.
6" W. OAK BEARS S 16° W 142'
SCRIBED 1/4 S 12 C S BT

16" W. OAK BEARS S 22° E 327'
SCRIBED 1/4 S 7 C S BT

J. B. J. P.
D. M.
Nov. 17-61

FENCE THIS

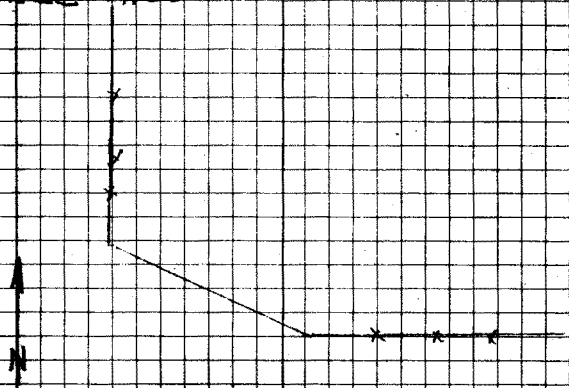

DIETZGEN NO. 385-6

* + O ✓

C.S. File No. 49/64-33