

RENEW $\frac{23}{9}$ T285 R5W

FOUND - ALL FOUR ORIG. B.T.S.
ALL CHECK OK. ORIG. BE B.T.
NOW DEAD WE OPEN & FIND GOOD
SCRIBING "T S"

SET BRASS CAP AT CORNER
MARK COUNTY SURVEYORS OFFICE
1961 5403 T285 R5W
591510

NEW BT.
10" W. OAK BEARS S 80° E 23.5'
SCRIBED SID T 285 R 5W CORNER

*+O


RENEW $\frac{1}{4}$ COR. $\frac{1}{9}$ T285 R5W

FOUND - BOTH ORIG. B.T.S. ORIG. 14"
NOW 22" B. OAK S 86° W 27.9'
WE OPEN & FIND GOOD SCRIBING
"S" ORIG. 30" NOW W. OAK
BEARS N 19° W 26.0' SHOWS GOOD
SCAP. I DO NOT OPEN.

SET BRASS CAP AT COR. MKO
COUNTY SURVEYORS OFFICE 1961
 $\frac{1}{4}$ S A T 285 R 5W
39

NEW BT.
18" W. OAK BEARS S 51° 5 1/2' W 60.3
SCRIBED $\frac{1}{4}$ S T 285 R 5W

FENCE THIS

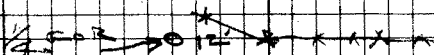

20% VAR

NOV 8 1961

J. B.
D. M.

*+O

C.C. 49/69

DIETZGEN NO. 385-B