


RENEW SOUTH 1/4 S 33 T 275 R 5W

FOUND - ORIG. 10" NOW 12" B.O.
N 15 1/4 W 133.3' NOT 130.3'
SHOWS GOOD SCRIBING ON OLD
FACE. 5". ORIG. 16" NOW 16"
B.O. N 15 1/4 E 180.8' SHOWS GOOD
SCAR II DO NOT OPEN.

SET BRASS CAP AT COR. MISSOURI
COUNTY SURVEYORS OFFICE 1961
S 1/4 S 33 T 275 R 5W.

NEW BTS.
RESCRIBE ORIG. NOW 36" B.O.
N 15 1/4 E 180.8' S 1/4 S 33 C.S.B.T.

12" B. OAK BEARS N 14° W 39.7'
SCRIBED S 1/4 S 33 C.S.B.T.

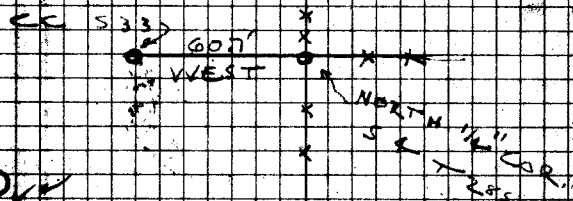

RENEW NORTH 1/4 COR. S.F. 1955

FOUND - ORIG. 30" NOW 36" PINE
SNAG S 30 1/4 W 288.8' SHOWS
GOOD SCRIBING 1/2"

SET BRASS CAP AT COR. MISSOURI
COUNTY SURVEYORS OFFICE 1961
NORTH 1/4 S 4 T 275 R 5W.

NEW BTS.

36" CEDAR BEARSS. 60° W 855'
SCRIBED N 1/4 S 4 C.S.B.T.

4 1/2" CEDAR BEARSS N 14° E 570'
SCRIBED N 1/4 S 4 C.S.B.T.

DIETZEN NO. 388-6

1961

C.S. File No. 49