



RENEW 31/32 T 275 R SW

FOUND - IRON BOLT AT COR.  
S. N.W. 28' R. FIR N 90° W NOT N 90° E  
11.5" SHOWS GOOD SCAR. ORIG.  
IN WEST NOW DOWN

NEW BT.  
21" R FIR BEARS WEST - 56  
531 T 275 R SW CS BT

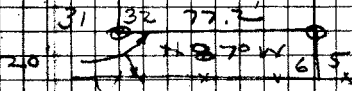

RENEW

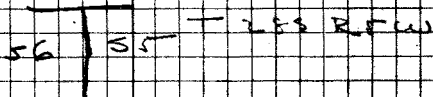

FOUND - IRON BOLT AT COR. ~~F~~  
BOTH BOTS WHICH SHOW GOOD SCARS

SET BRASS CAP AT COR. AND  
ALONGSIDE 11.3. MARK COUNTY  
SURVEYORS OFFICE 1961

56 | 55 T 283 R SW

VAR 20 1/2 0

DEC. 8-61  
H.B.  
J.B.  
J.B.

DIETZEN NO. 388-6

\* \* 00 ✓

C.S. File No. 79/64 193