

RENEW $\frac{115}{7 \frac{1}{2}}$ T 295 R 5W

FOUND - ORIG. NE & NW BPTS
MARKERS SE & SW BPTS SW BT
NOW: STUMP SHOWS SCRIBING SE
BT DOWN SHOWS SCRIBING NE
ALSO FIND $\frac{1}{2}$ " I.P. AT COR.

SET BRASS CAP ALONGSIDE I.P.
MARK COUNTY SURVEYORS
OFFICE 1962 $\frac{5615}{57 \frac{1}{2}}$ T 295 R 5W

NEW BPTS.
5" W. OAK BEARDS S 33° W 17.3'
SCRIBED 57 CS BT.

10" LAUREL BEARDS S 11½° E 42.7'
SCRIBED 58 T 295 R 5W CS BT.


DIETZGEN NO. 3885-6

RENEW $\frac{1}{4}$ COR. 615 T 295 R 5W

FOUND - BOTH BPTS AS RECORDED
BY SA IN 1920. WE OPEN NE BT
FIND GOOD SCRIBING. NW BT
SHOWS GOOD SPAR.

SET BRASS CAP AT CORNER MKD,
COUNTY SURVEYORS OFFICE 1962
 $\frac{1}{4}$ 5615 T 295 R 5W.

NEW BT.
10" LAUREL BEARDS N 15° E 20.4'
SCRIBED $\frac{1}{4}$ 5 CS BT

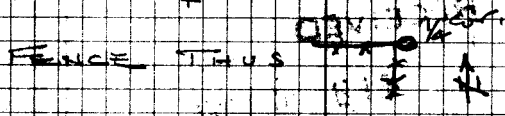

FENCE THIS

VAR 204°
FEB 5-1962
J.P.
M.M.

+ * O v

C.S. File No. 19/62-57