

RENEW $\frac{718}{181517}$ T 295 R 5 W

FOUND ALL BEAR POTS
BITE IN WITH UNIFORMS DESCRIBING
WE ALSO FIND MOUND OF STONE
OLD SO STAKE AT COR.
SET BRASS CAP AT CORNER, MND
COUNTY SURVEYORS OFFICE, 1962
STAKE T 295 R 5 W
5181517

NORTH, SOUTH FENCE 1.5' EAST

NEW BT.

21 W. OAK BEARS N 65° E 81.3'
SPRIDDEN ST C S B T.





RENEW $\frac{7115}{25121}$ T 295 R 5 W

FOUND 1/2" IP AT CAR 1/2 W BT AS
RECORDED BY STEWART 1921. OTHER
BTS NOT FOUND.

CHISEL 2" T ON TOP 12" X 16" X
18" HIGH STONE BEARS N 60° E 290'
NO OTHER TOPERS NEAR

FACE

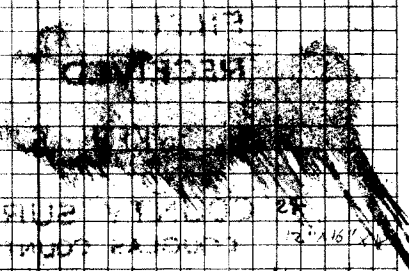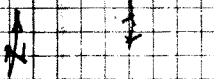

PROVINCIAL... 25
... 2016' ...
... 11/1/23

DIETRZEN NO. 385-6

+ * O ✓ 2/1962

C.S. File No. 49/64059