

RENEW $\frac{1}{4}$ COR 13 T 29 S R 4 W
20

FOUND - BOTH OF BRASS SETS BOTH
CHECK RECORD BEARING & DIST.
EACH SHOWS GOOD SCHEMING
THE NEW BT NEW STUMP ONLY, THE
SW BT IS OK


SET BRASS CAP AT CORNER
MND COUNTY SURVEYORS OFFICE
1960 $\frac{1}{4}$ S 13 T 29 S R 4 W
JWA

NEW BT:
DESCRIBE NOW 7" CEDAR 54 1/2 W
148' $\frac{1}{4}$ S 24 C S BT

12" R. FIR BEAMS N 24° W 187'
SCRIBED $\frac{1}{4}$ S 13 C S BT

VAP 20 1/2

JUL 7, 1960
L. B. J.
M. G.
D. V.

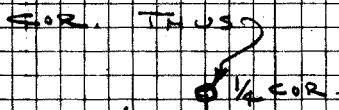

FILED
RECEIVED

JUL 7 1960

COUNTY SURVEYOR
COUNTY SURVEYOR
DOUGLAS COUNTY, ORE.

C. S. File No. 49/67-6

DIETZGEN NO. 385-6