

RENEW SW COR. DLC. 37 T29S R9W


FOUND - ORIG. 1P" NOW 48" ASH.

N 5° E 82.5' PREVIOUSLY OPENED

SHOWS SCRIBE MARKS 'S' 1".

NW BT NOT FOUND.

FENCES THUS

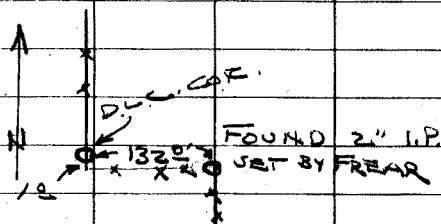

SET BRASS CAP AT CORNER MARKED

COUNTY SURVEYORS OFFICE 1960

SW COR. DLC. 37 T29S R9W.

NEW BTS.

14" ASH BEARS N 59° E 19.8'

SCRIBED SW DLC 37 CS BT

9" ASH BEARS N 38° W 26.3'

SCRIBED SW DLC 37 CS BT

\* 7/1960

✓✓  
CS 49/67 -7