

REVIEW $\frac{1}{4}$ COR $\frac{7}{18}$ T285 RAW

FOUND - BOTH ORIG. BTS. EACH IS
BARK SCRIBED $\frac{1}{4}$ " AND EACH CHECKS
BEARING & DIST. WE ALSO FIND
 $\frac{1}{4}$ " I.P. AT COR AND FENCES
THUS




NEW BT.
7" R. FIR BEARS S 42° E 25.9'
SCRIBED $\frac{1}{4}$ " CS BT

JULY 6-61
J.B.
M.G.

RESCRIBE NOW 30" R. FIR N 65° E 20.5'
 $\frac{1}{4}$ " S 7" CS BT - NOTE NEW SCRIBING
HOW NEAR BASE OF BT.



REVIEW SE COR DCC 37 T285 RAW
FOUND - ORIG. 10" NOW 28" W. OAK
N 15° W 94.4' WE OPEN & FIND FRENDS
SCRIBING "T". WE DO NOT FIND $\frac{3}{4}$ " I.P.
SET BY FRENDS.
NOTE - FENCE COR. THUS

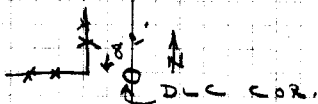

SET BRASS CAP AT COR. MKD. COUNTY
SURVEYORS OFFICE 1961 SE COR.
DCC 37 T285 RAW.

NEW BTS.
12" W. OAK BEARS N 41° W 76.4'
SCRIBED SE DCC 37 CS BT
10" W. OAK BEARS N 65° W 80.9'
SCRIBED SE DCC 37 CS BT

C.S. File No. 49/67-8