


RENEW ⁵³/₃ T295 R4W
T295

FOUND - 3/4" I.P. AT COR. &

BOTH BTS AS RECORDED BY
STEWART, 1922. SE BT NOW DOWN
SHOWS SCRIBE MARKS. SW BT SHOWS
GOOD SCAR.

OLD BOARD FENCE COR. THUS

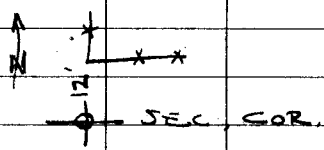

SET BRASS CAP ALONGSIDE COR.
PIPE & MARK COUNTY SURVEYORS
OFFICE 1961. ⁵³³/₅₃₄ T295 R4W
⁵⁴/₅₃ T295

NEW BTS.

2" R. FIR BEARS S 51 1/2° E 302'
SCRIBED S3 T295 R4W CS BT

5" R. FIR BEARS S 82 1/2° E 244'
SCRIBED S3 CS BT

FILED
RECEIVED

AUG. 17-61

J. B.
J. M.
J. P.

AUG 17 1961

*+
COUNTY SURVEYOR
DOUGLAS COUNTY, ORE.

CS 42/67-21
OO