

REN. T 28 S R 4 W COR. SECS. 3 | 2
10 | 11

AT COR. FD. G.L.O. BRASS CAP
SET IN 1958 SURVEY.

FD. 24" FIR SNAG N 40° W 56 FT
BARK SCRIBED.

FD. 13" CEDAR SNAG N 20 $\frac{3}{4}$ ° E 95 $\frac{1}{2}$ FT.

ALL SCRIBING VISIBLE.

ALL OTHER B.T.'S ARE BLOWN
DOWN & LOGGED, OR GONE.

BLAZE & SCRIBE NEW TREES:

12" DOUG. FIR S 41° E 57 $\frac{1}{2}$ FT.

MKD. "T 28 S R 4 W S 11 CSBT"

5" DOUG. FIR S 24° W 47 $\frac{1}{2}$ FT.

MKD. "S 10 CSBT"

9" DOUG. FIR N 38° E 111 $\frac{1}{2}$ FT.

MKD. "T 28 S R 4 W S 2 CSBT"

11" DOUG. FIR N 70° W 87 $\frac{1}{2}$ FT.

MKD. "T 28 S R 4 W S 3 CSBT"

JUNE 5, 1944

Milo C. Godfrey

M.G.

W.S.


M.D.

M.S.

+ X O ✓

C.S. File No. 113/63-3A

Section 3 Twp 28 S Rge 4 W 19-63 Date: 3-19-63

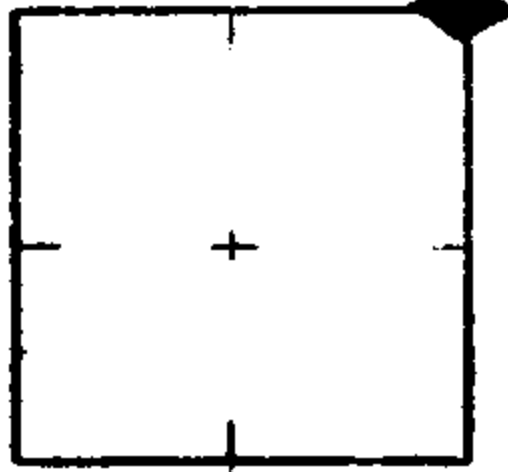

How was corner identified? Brass Cap

Condition of corner:

Best route to reach corner: Head 28-4-7

RENEWED

Quadrant	NE	NW	SE	SW
Species & Size	11" I. Cedar	32" D. Fir	22" D. Fir	34" D. Fir
Dist. & Bearing	144 lks. N20 1/2 E	43 lks. N51 3/4 W	22' S32 E	30' S31 W
Condition of Scribe			Bark scribe	Bark scribe
Original or Resurvey				
Appearance of B.T.	Sn + 9	Wind throw	Wind throw	Wind throw
Tags, Marks, etc.				

Other Remarks:

J. Boyles BLM
CS 491 67-39 Signed