


RENEW 1/4 COR 1 | 6 T213
 RSW RAW

FOUND - ORIG. 36" NOW 60" CEDAR
 SHOWS GOOD SPRING ON
 ROTTEN FIR STUMPS WE DO NOT
 GOOD SPRING NEAR BRASS
 WE ALSO FIND RICHARDSON'S
 BT AS RECORDED BUT DO NOT
 FIND AUTO SPRING SET FOR
 COR.

WE FIND BT TRUS

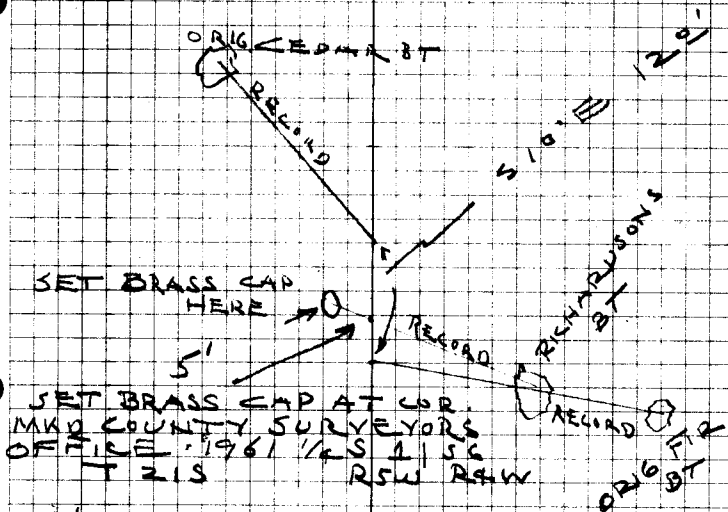

NEW BT
 12" W. FIR BEARS N 38° W 172
 SCRIBED 1/4 S 1 CS BT

JUNE 19-61

H. D.

C.S. File No. 49/68-9

DIETZGEN NO. 385-6