

SEARCH FOR

8/9


T255 R7W

WIT 2' +

FOUND - 12" X 8" X 6" STONE AT CORN
 NOW 6 1/2" FIR BEARS N 45° E 1 1/4"
 WHICH IS 2 RECORDS BARK SCRIBED
 T255 R7W - 59 BT. SCRIBING
 APPEARS TO BE ORG. DIA. OF BT. JERMS
 TOO GREAT FOR ORIG.

I ALSO FIND ORIG. 10" NOW 2 1/2" R. FIR
 NOW N 26.5° (RECORD N 37° W 5.3")
 I OPEN & FIND GOOD SCRIBING TWICE
 COUNT & SIZE. CHECK FOR ORG. BOTH
 BIG FACE TO STONE
 I DO NOT FIND MAPLES AS ORIG. SET
 FOR BT5.

(RECORD 1882)

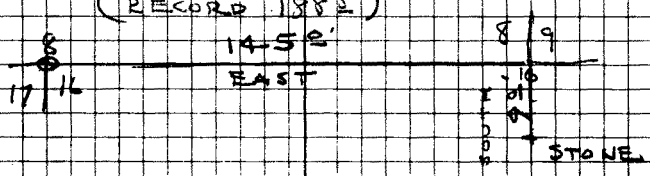

DIETZEN NO. 385-6