

FD. O.K. -


MEANDER COR. - RT. BANK

T 25 S R 7 W $\frac{S 24}{S 23}$

FD. B.T. (DR19) REMARKED BY B.B.I. IN 1932 - OTHER B.T. COR. IRON PIPE SET BY B.B.I., WASHED OUT BY RIVER.

COR. NOT RENEWED. - POSITION FOR COR. NOW BELOW HIGH BANK - WOULD HAVE NECESSITATED SETTING WIT. COR. - $\frac{1}{4}$ COR. (RENEWED) IS ONLY APPROX. 80 FT. FROM M.C. - I DID NOT FEEL JUSTIFIED IN SETTING W.C. TO M.C. SO NEAR $\frac{1}{4}$ COR.

DIETZGEN NO. 385-6

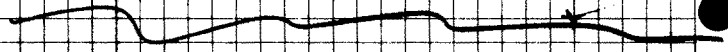

NOT FD. COR. SECS. $\frac{1}{12}$

FILED T 25 S R's 7 & 8 W RECEIVED

AUG 5 1963

COUNTY SURVEYOR DOUGLAS COUNTY, ORE.

CS 49/76-26